


1546, 97

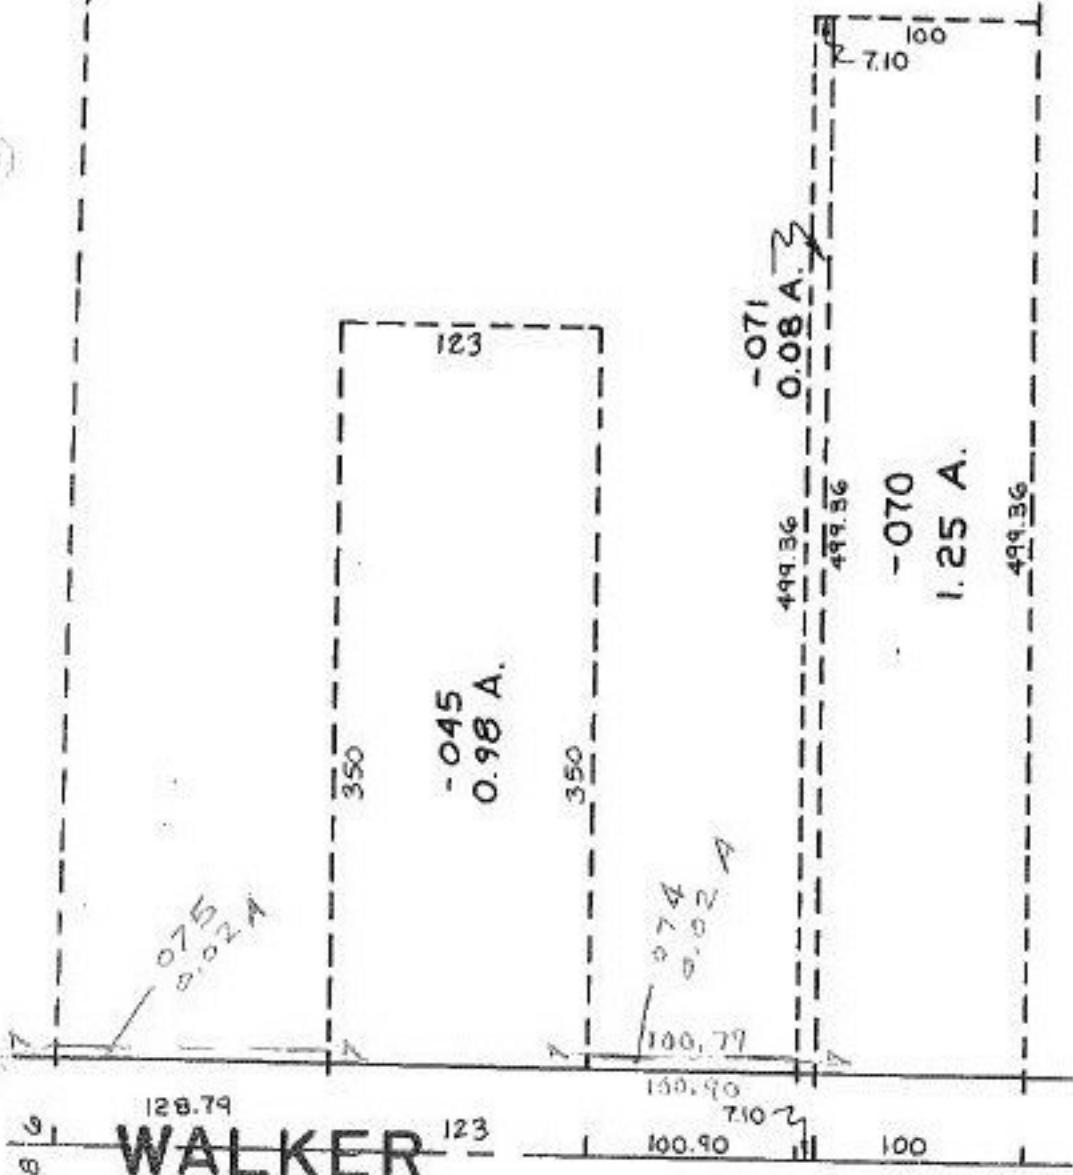

04-00-030-141-

Prior Decd 1427-25
Survey - K.S.A
C-1 NF

ON 11-24-87

#17762

APPROVED
LORAIN CO.
MAP DEPT.

338.70

18811
WALKER

SEE 4-D