

1203.19  
1123.19

~~963.19~~  
1043.19

( only one parcel Filed 12-8-87 )  
TRANSFER SHEET #21  
(O.R.) 30-152

- 033

~~- 034~~  
~~= 031~~

~~13.38 A.~~  
~~11.10 A.~~  
12.24 A

SN 12-18-87  
# 17769

APPROVED
LORAIN CO.
MAP DEPT.
DATE 11-18-87
PAGE 6-130
BY CAROL FRANCIS
VOID AFTER * 17769

City Corp. Line 2  
Twp. 19.21

06-24-006-000

Prior Deed 1280-523

Surveyed By: K.S. Ac.


1 C = 1:50000

2 C = 1:25000

City Ord. No. 70-134

892.21

SEE 10-B

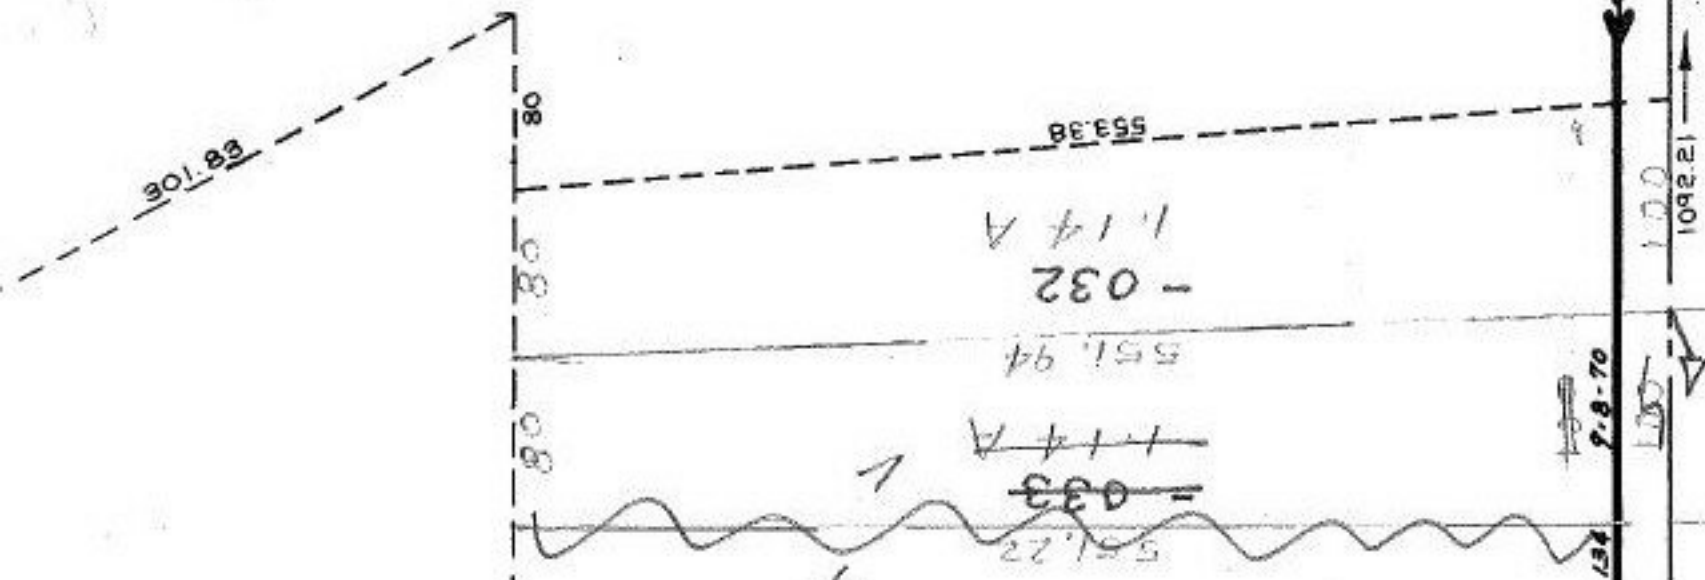

- 032  
1.14 A

551.94

~~1.14 A~~

~~033~~

551.22

553.38

301.83

80

30

30

9.8-70

100

1092.21