


SEE 4-00-014-A

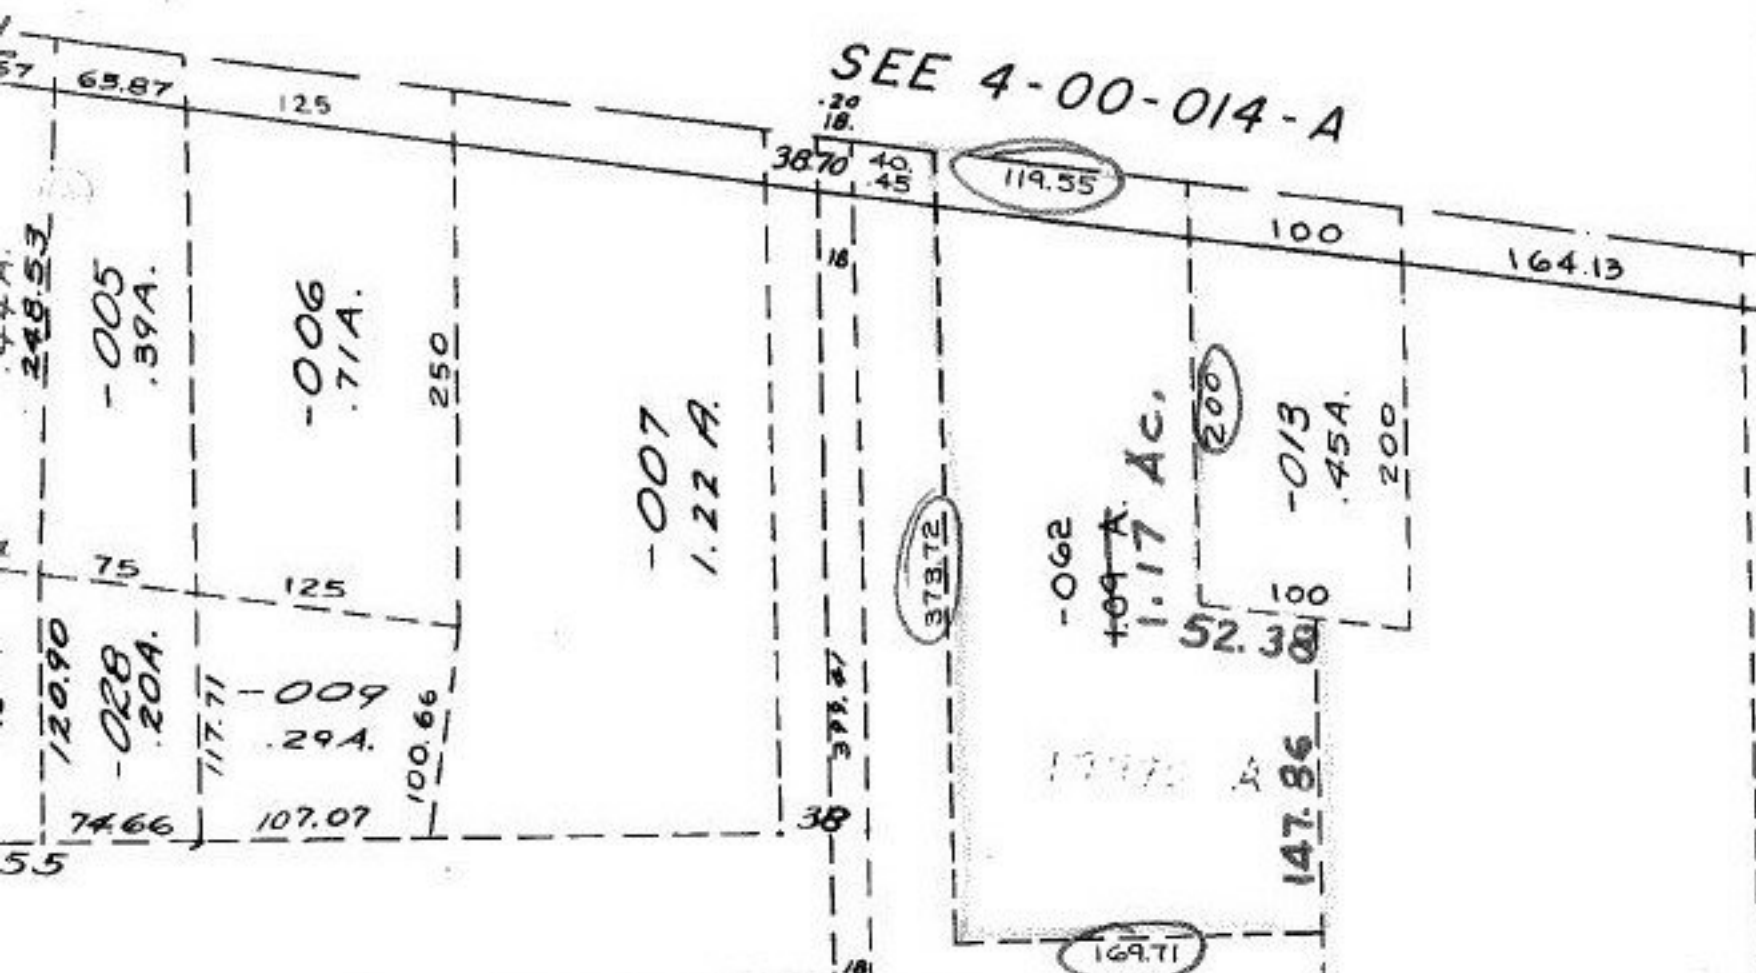

Ae. CORR. PER Deed
 Surveyed BY: W. B. Barton
 Reg. Surveyor

C = 1.142857

Ae. Corr.

-061
3.60 A.

-012
4.70 A.

11-24-87
 #17770-A

APPROVED
LORAIN CO.
MAP DEPT.
DATE 11-19-87
PAGE 4-00-014-E
CAROL-FRANCIS
17770-A

04-00-014-105