


05-00-026-101
PRIOR DEED 1108-504
Survey By: K.E. McCartney & Assoc.
C=1: 333333
SEE 5-00-026-A

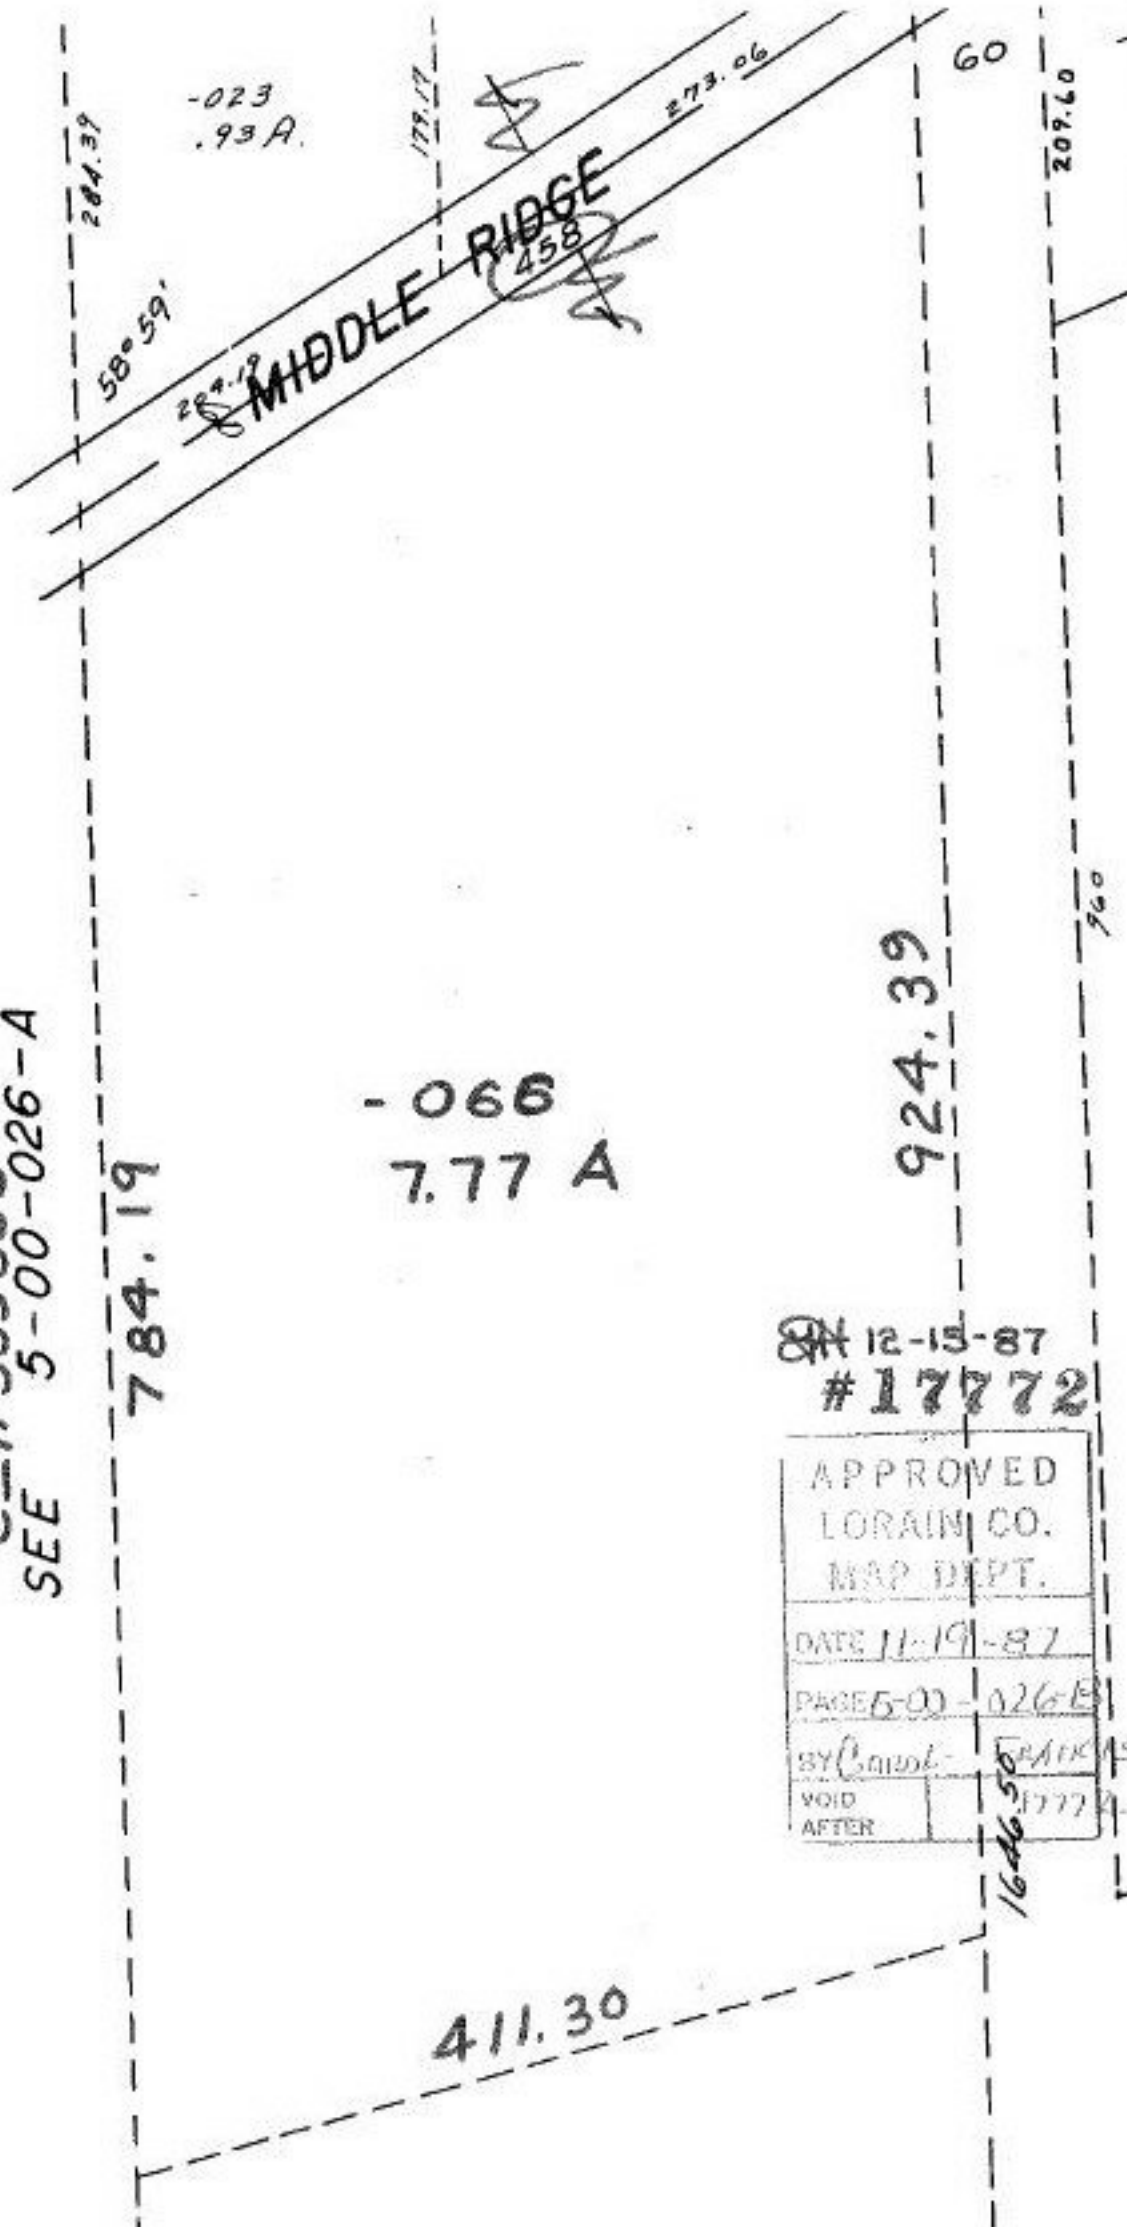

- 066
7.77 A

12-15-87
17772

APPROVED	
LORAIN CO.	
MAP DEPT.	
DATE 11-19-87	
PAGE 5-00-026-A	
BY Carol FRANKS	
VOID	17772
AFTER	

1646.50