


-023
0.20 A.

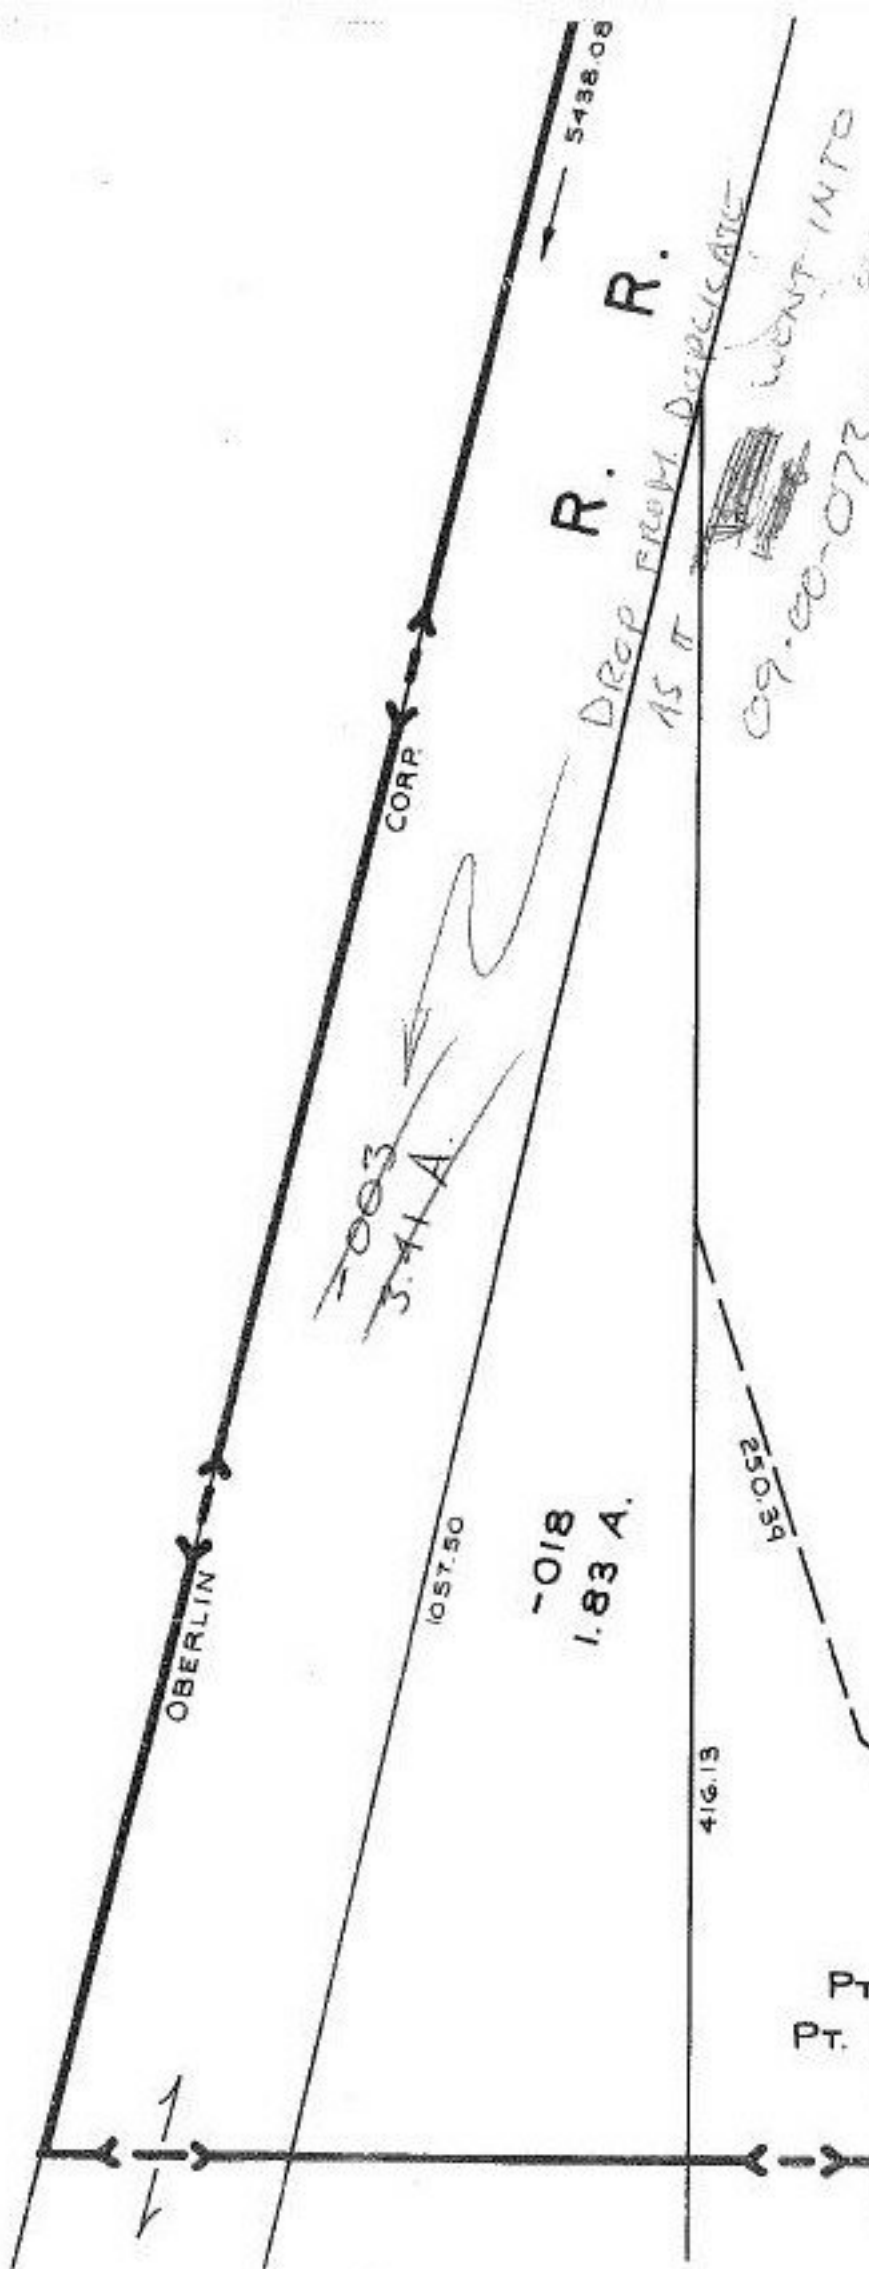

PT. -028
PT. 13.71 A.

12/29/87
#17795-A

PT. 1027
PT. 1.97

PROP FROM
DUPLICATE

APPROVED	
GRAIN CO.	
MAP DEPT.	
DATE 12-15-87	
PAGE 9.00.093	
BY T. Mulvaney	
VOID AFTER	

8.00.093 A