


Q. OF BUTTERNUT RIDGE
RD. 2.55' EAST OF TWP. LINE.

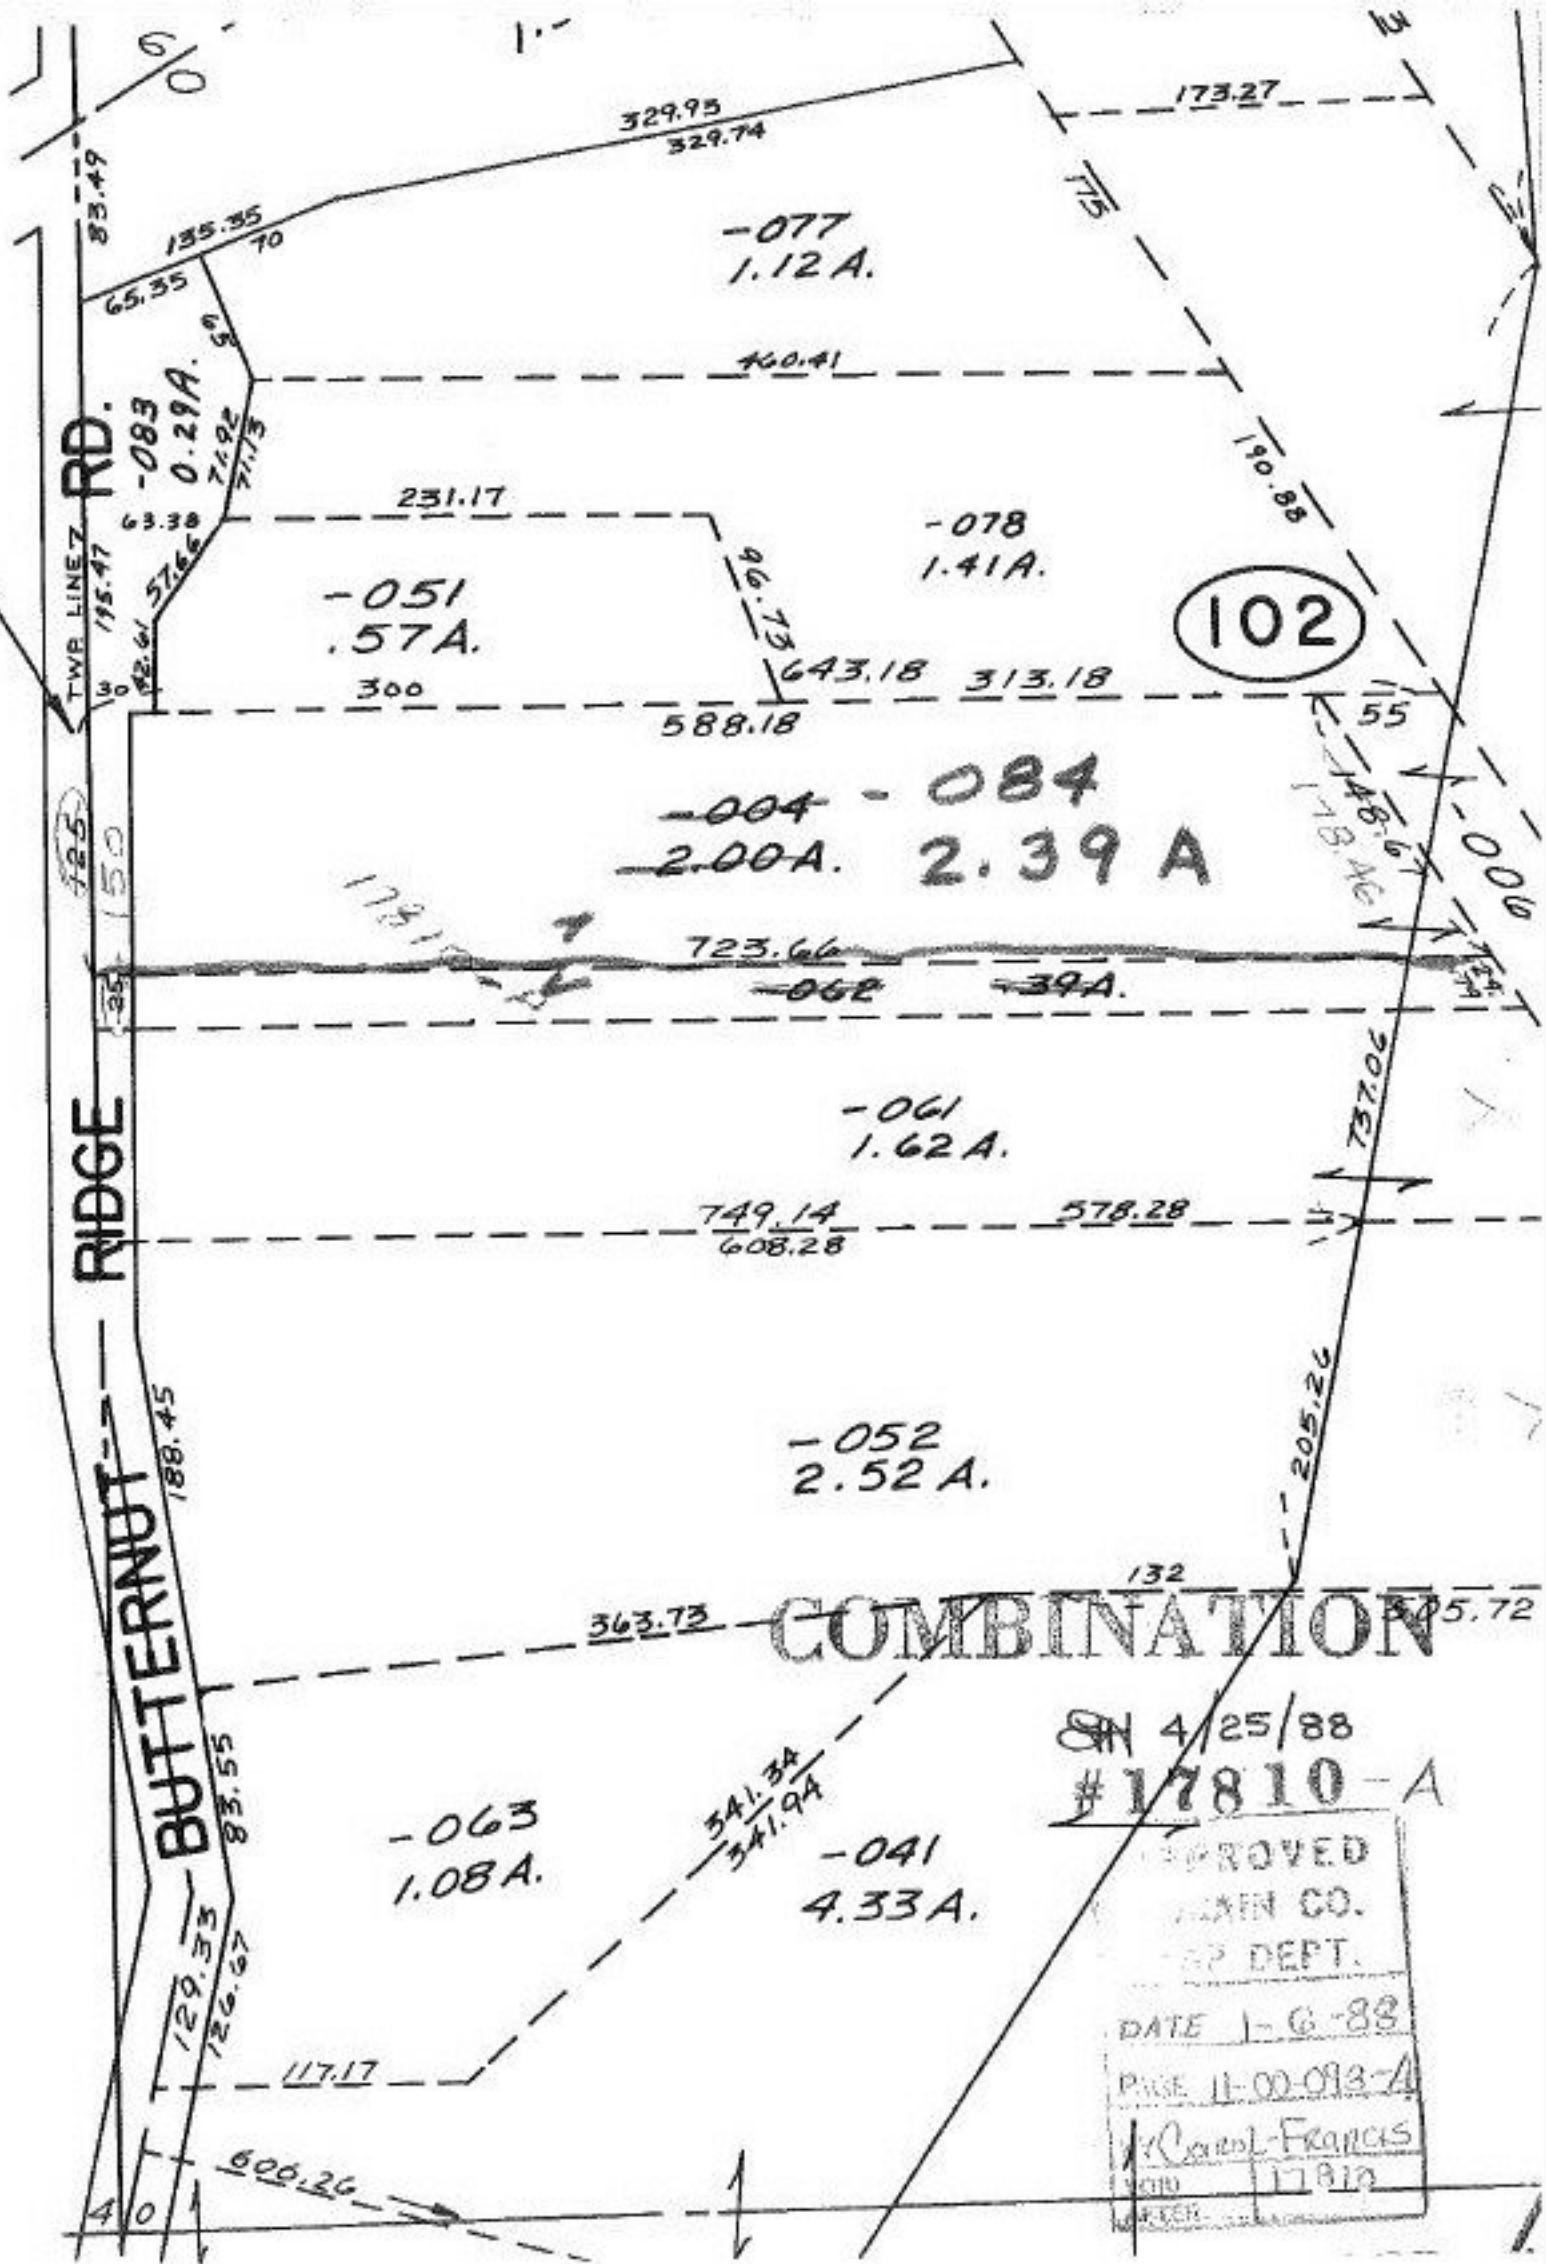

COMBINATION

SN 4/25/88
#17810-A

APPROVED
MAIN CO.
TWP DEPT.
DATE 1-6-88
PAGE 11-00-093-4
C. Francis
17810