

004
92 A


17814

004
65.92 A

-125
66.83 A



10-00-024-000
PRIOR Deed 1414-851
Surveyed by
DAVID ELWELL
Reg. Surveyor (C-111NF)
(Parallel Lines)

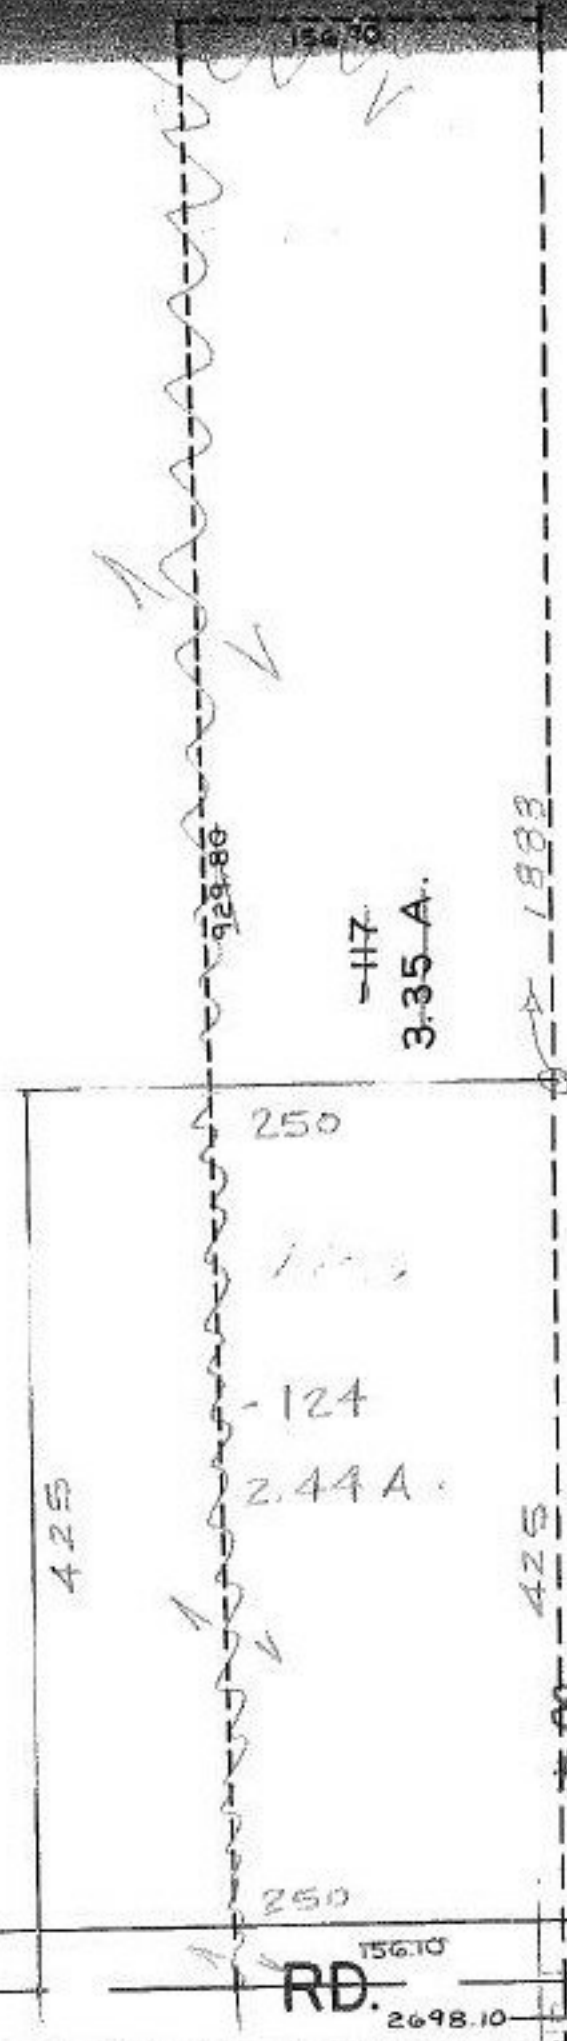

SEE 10-00-024-D

4/20/88
#17814

APPROVED
LORAIN CO.
MAP DEPT.

1-6-88

PAGE 10-00-024-C

BY *Crest Francis*
VOID *17814*

1169.50

~~919.50~~ 1075.60

RD.

156.70

2698.10