


434.50

ST.
238.92

49.50

-009
2.50 A.

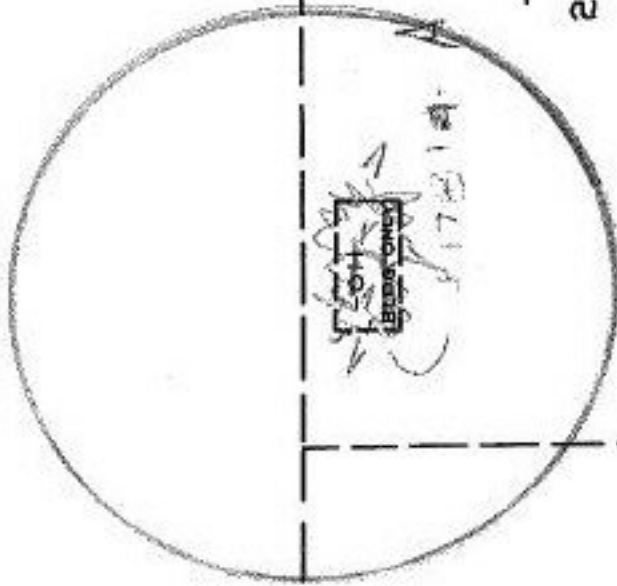

DROP
FROM
DUPLICATE

BLDG. ON LEASED
PER! MARK STEWART.

LAND

Chief
APPRAISER

Pt. 09-00-095-101-030
Pt. 12.46 A.

-007
16.00 A.

1545

4/20/88
#17814 - A

APPROVED
LORAIN CO.
MAP DEPT.
DATE 1-13-88
PAGE 9-00-094-B
BY Carol-FRANCIS
VOID AFTER 17814-A