


SEE 100-008-B

301

662148

496.47

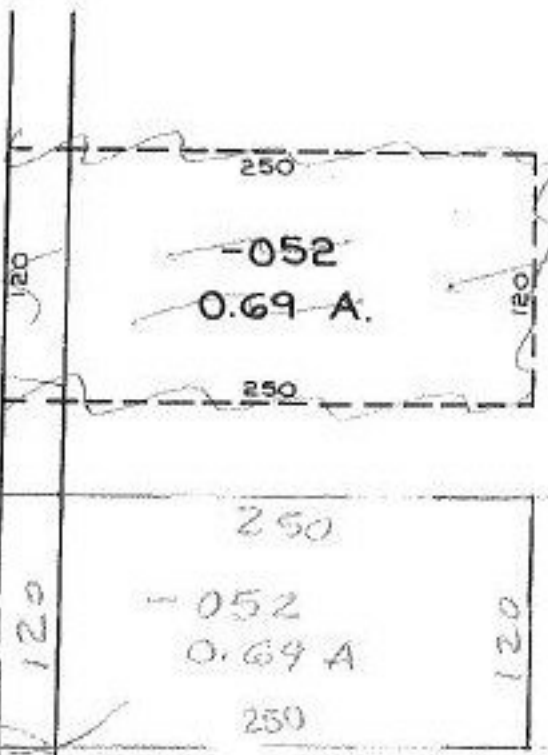

PARCEL DRAWN IN WRONG PLACE - MOVE PARCEL DOWN.

PARCEL SHOULD HAVE BEEN DRAWN 662.48 FROM E OF CARLISLE & LAGRANGE RD. NOT FROM N.W. CORNER OF SUBLOT ONE.

See DV. 1406-460
10-00-008-113

ON 4/20/88
#17816-A

APPROVED
LORAIN CO.
MAP DEPT.
DATE 1-11-88
PAGE 10-00-008-C
BY Carol-Francis
VOID AFTER 17816-A

MAP CORR.

89°14'

30	159.53	50	"	"	"	"	"	"	50	51.82	50	48.18
68.51	1-007	68.50	50	4-010	5-049	7-013	8-014	9-015	10-016	11-017	ST.	12-018
160.45		136	50							136		
67.50	2-008	67.50	50							50		
161.35		136	50							50		

CARLISLE

Y H C