



SEE 7-00-034

Survey

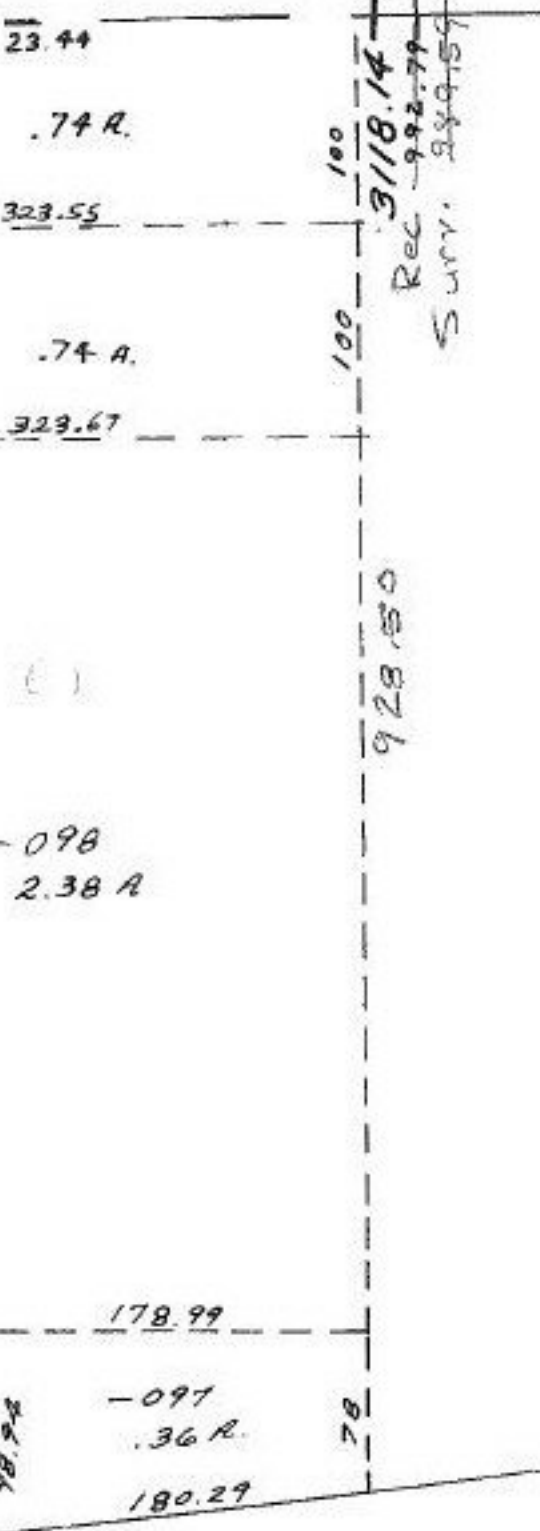

17810

Pt. -107
Pt. -059
Pt. 15.00A.
12.04A

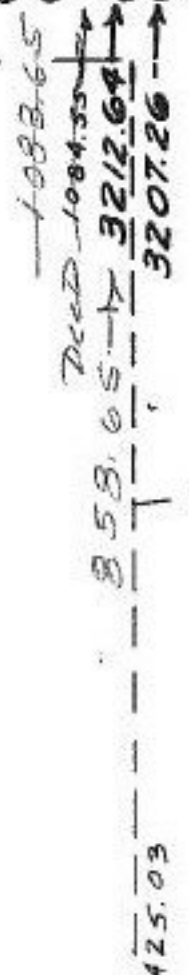

07-00-034-000
Prior Deed 838/22
Surveyed by K.S. Assoc.
C=1:50000

4/18/88
17818

APPROVED
LORAIN CO.
MAP DEPT.
DATE 1-15-88
PAGE 7-00-034-C
BYC, FRANCIS
VOID AFTER 17818

Pt. - C

619.14

OHIO