

1782

(Handwritten scribble)

Change Parcel Number on 4-H

10.00
1.42
8.58
8.37
8.21
37
142
100.0

H-t
4-028-G


101

2143.32
2152.43

#1782

-043
Pt. -026
Pt. 70.00A
8.31A.

(Handwritten scribble)

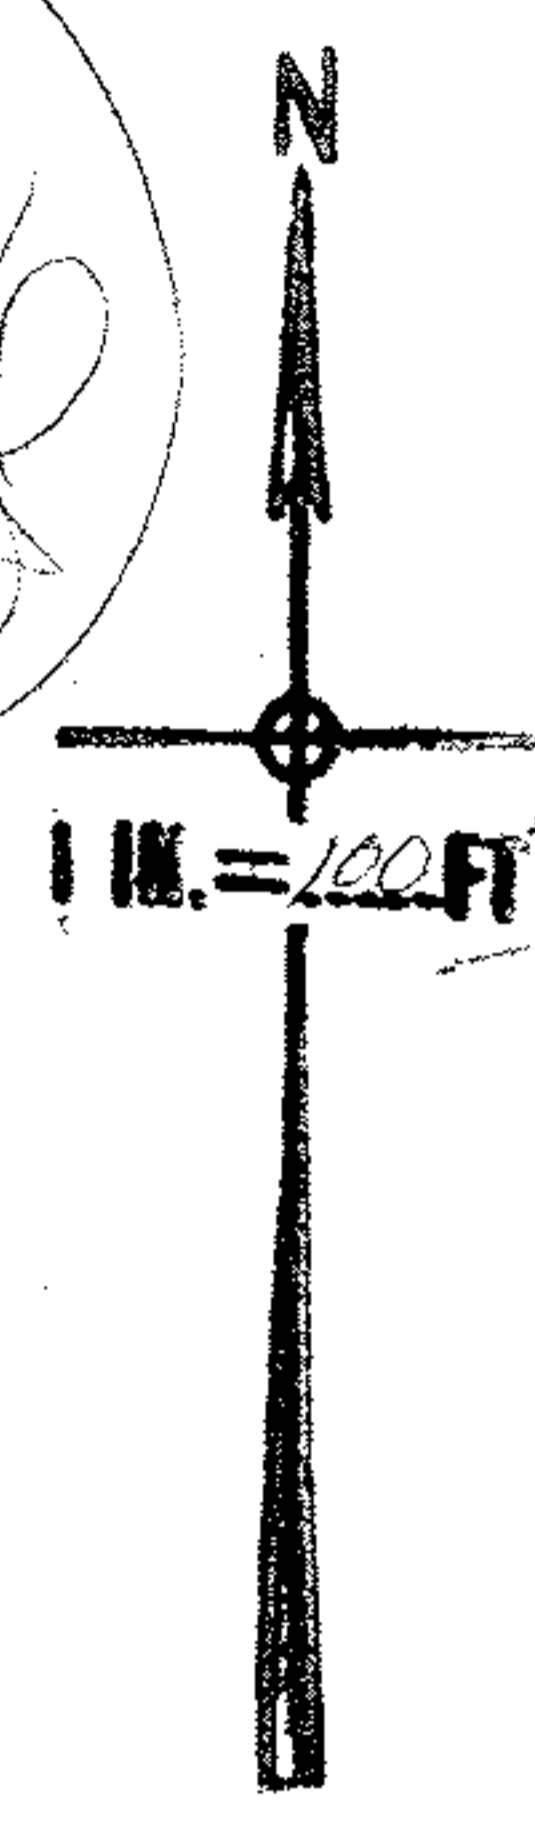

1782

APPROVED
LORAIN CO.
MAP DEPT.
DATE 5-18-68
4-0-028-G 4A-H
BY
(Signature)
88 98-31A

SERVICE

81.30 204.83
-042 0.37A
205.63

RD

90

-041
1.42A.

299.37

CHESTER

74.07 A
102.53
206.197 RD
180
-044
23A
84.39

SEE 4-00-028-H

DONE 5/18/68 W. Kelly's

146.19
152.55
298.77

430

-045
86A.

430