


#1783  
**APPROVED**  
**LORAIN CO.**  
**MAP DEPT.**  
 DATE 5-18-68  
 12-00-015A  
 BY *W. Maynard*

*A. A.*  
 7-25-68

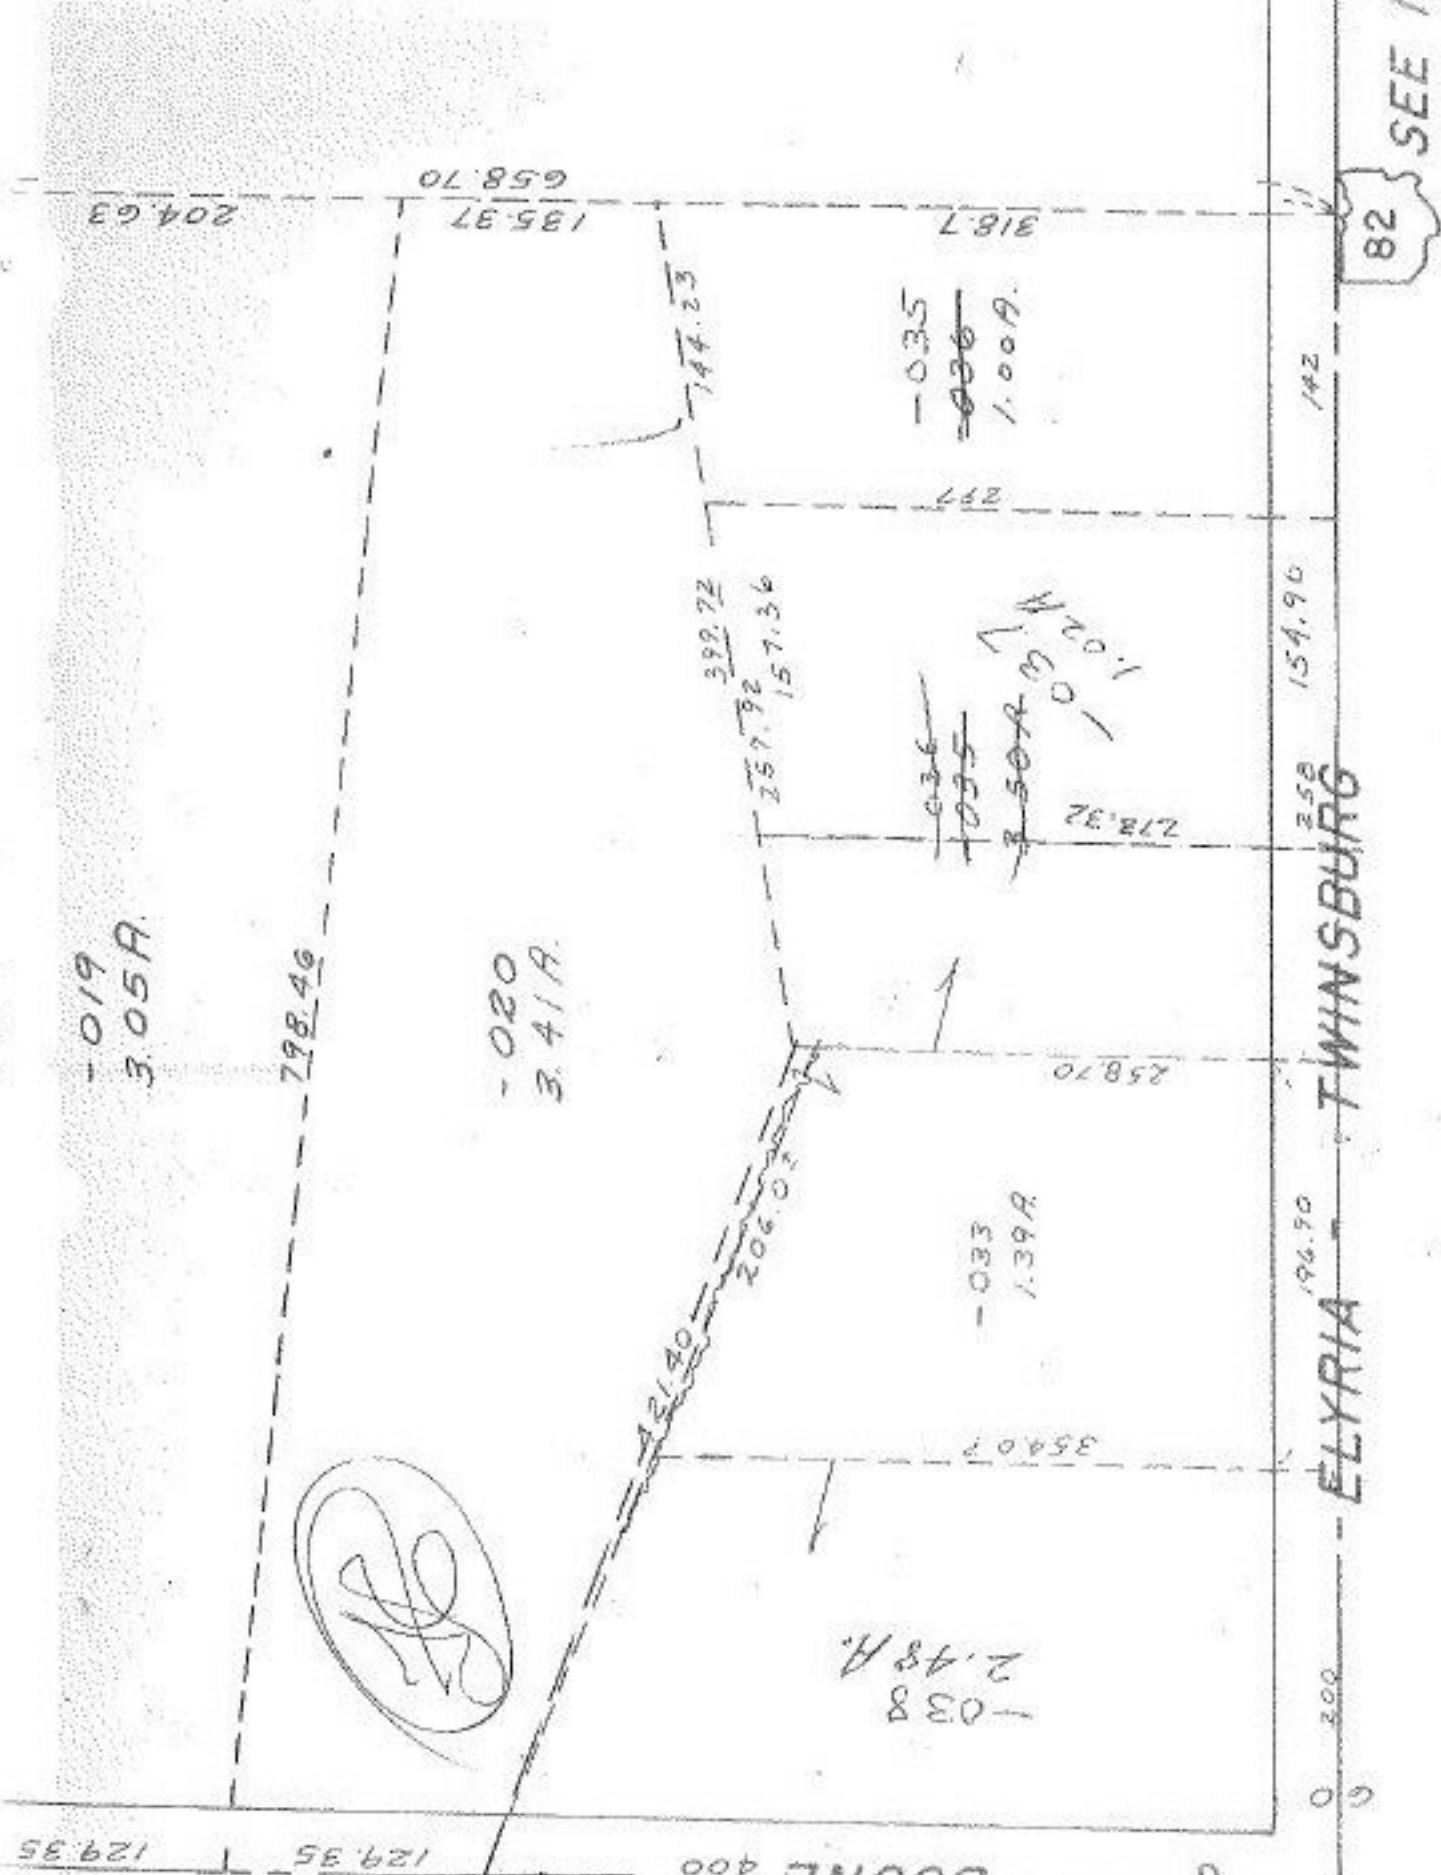

# COLUMBIA TWP.

SCALE: 1" = 100'

*Done 6/15/68*  
*Woodruff*  
 7018-30-11