


SEE

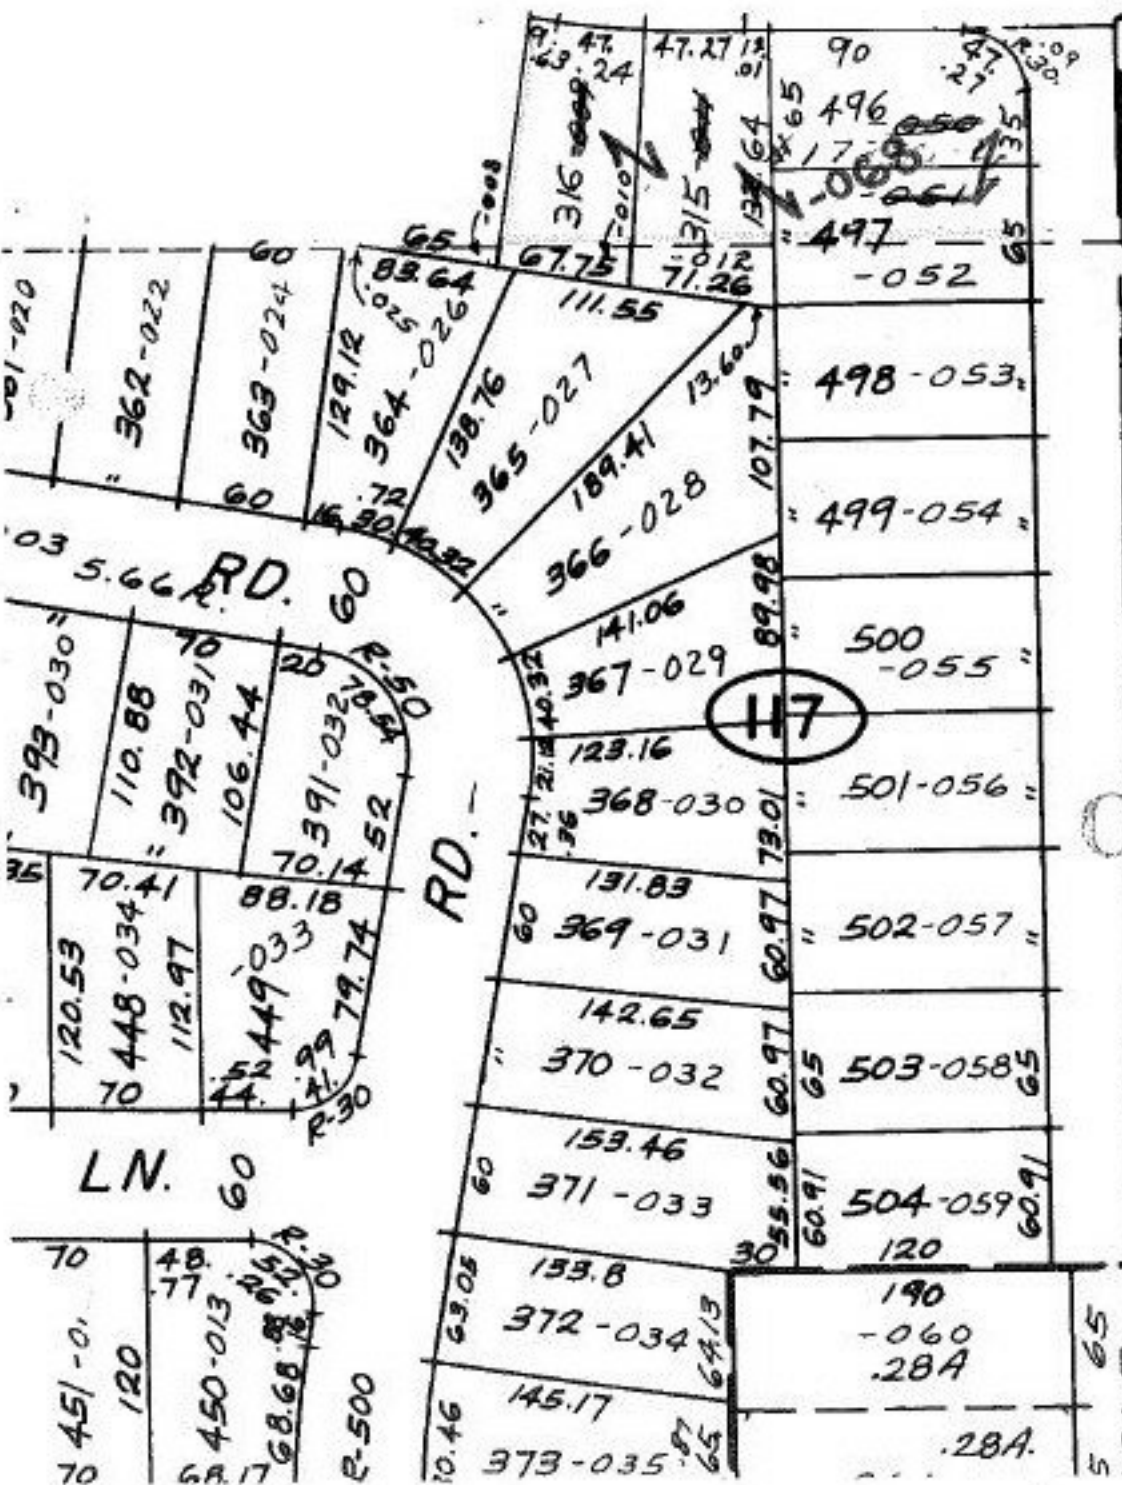

COMBINATION

SA 4/4/88
#17850-A

APPROVED
LORAIN CO.
MAP DEPT.
DATE 2-18-88
PAGE 4-00-024-D
BY Carol Francis
WORD AFTER * 17850-A

SEE