

Pt. - 025  
Pt. 43.92 A.


WEST  
LINE 1270

~~.024~~  
Pt. .002  
Pt. 60.54 A.  
~~30.54 A~~

DRAW ALL  
PARCEL ON  
11-00-019-B

CFE 11-00-019-B

COMBINATION

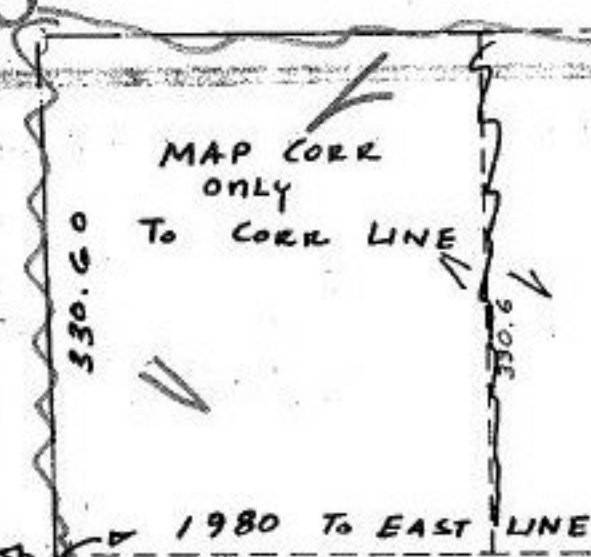

To West LINE ←

2265.30 → To East Line

OF PARCEL  
ON 4/25/88  
#17852-B

COMBINATION

<del>003</del>	<del>30.54 A</del>
<del>024</del>	<del>13.38 A</del>
- 025	43.92 A

~~#17881~~  
APPROVED  
LORAIN CO.  
MAP DEPT.  
DATE 1-22-88  
PAGE 11-00-019-A

APPROVED  
LORAIN CO.  
MAP DEPT.  
DATE 2-23-88  
PAGE 11-00-019-A  
BY Carol-Francis  
VOID AFTER \* 17852-B