


Combined

-150	0.67
-151	0.78
-208	3.45
<hr/>	
	4.90 A

171.42  
336.58

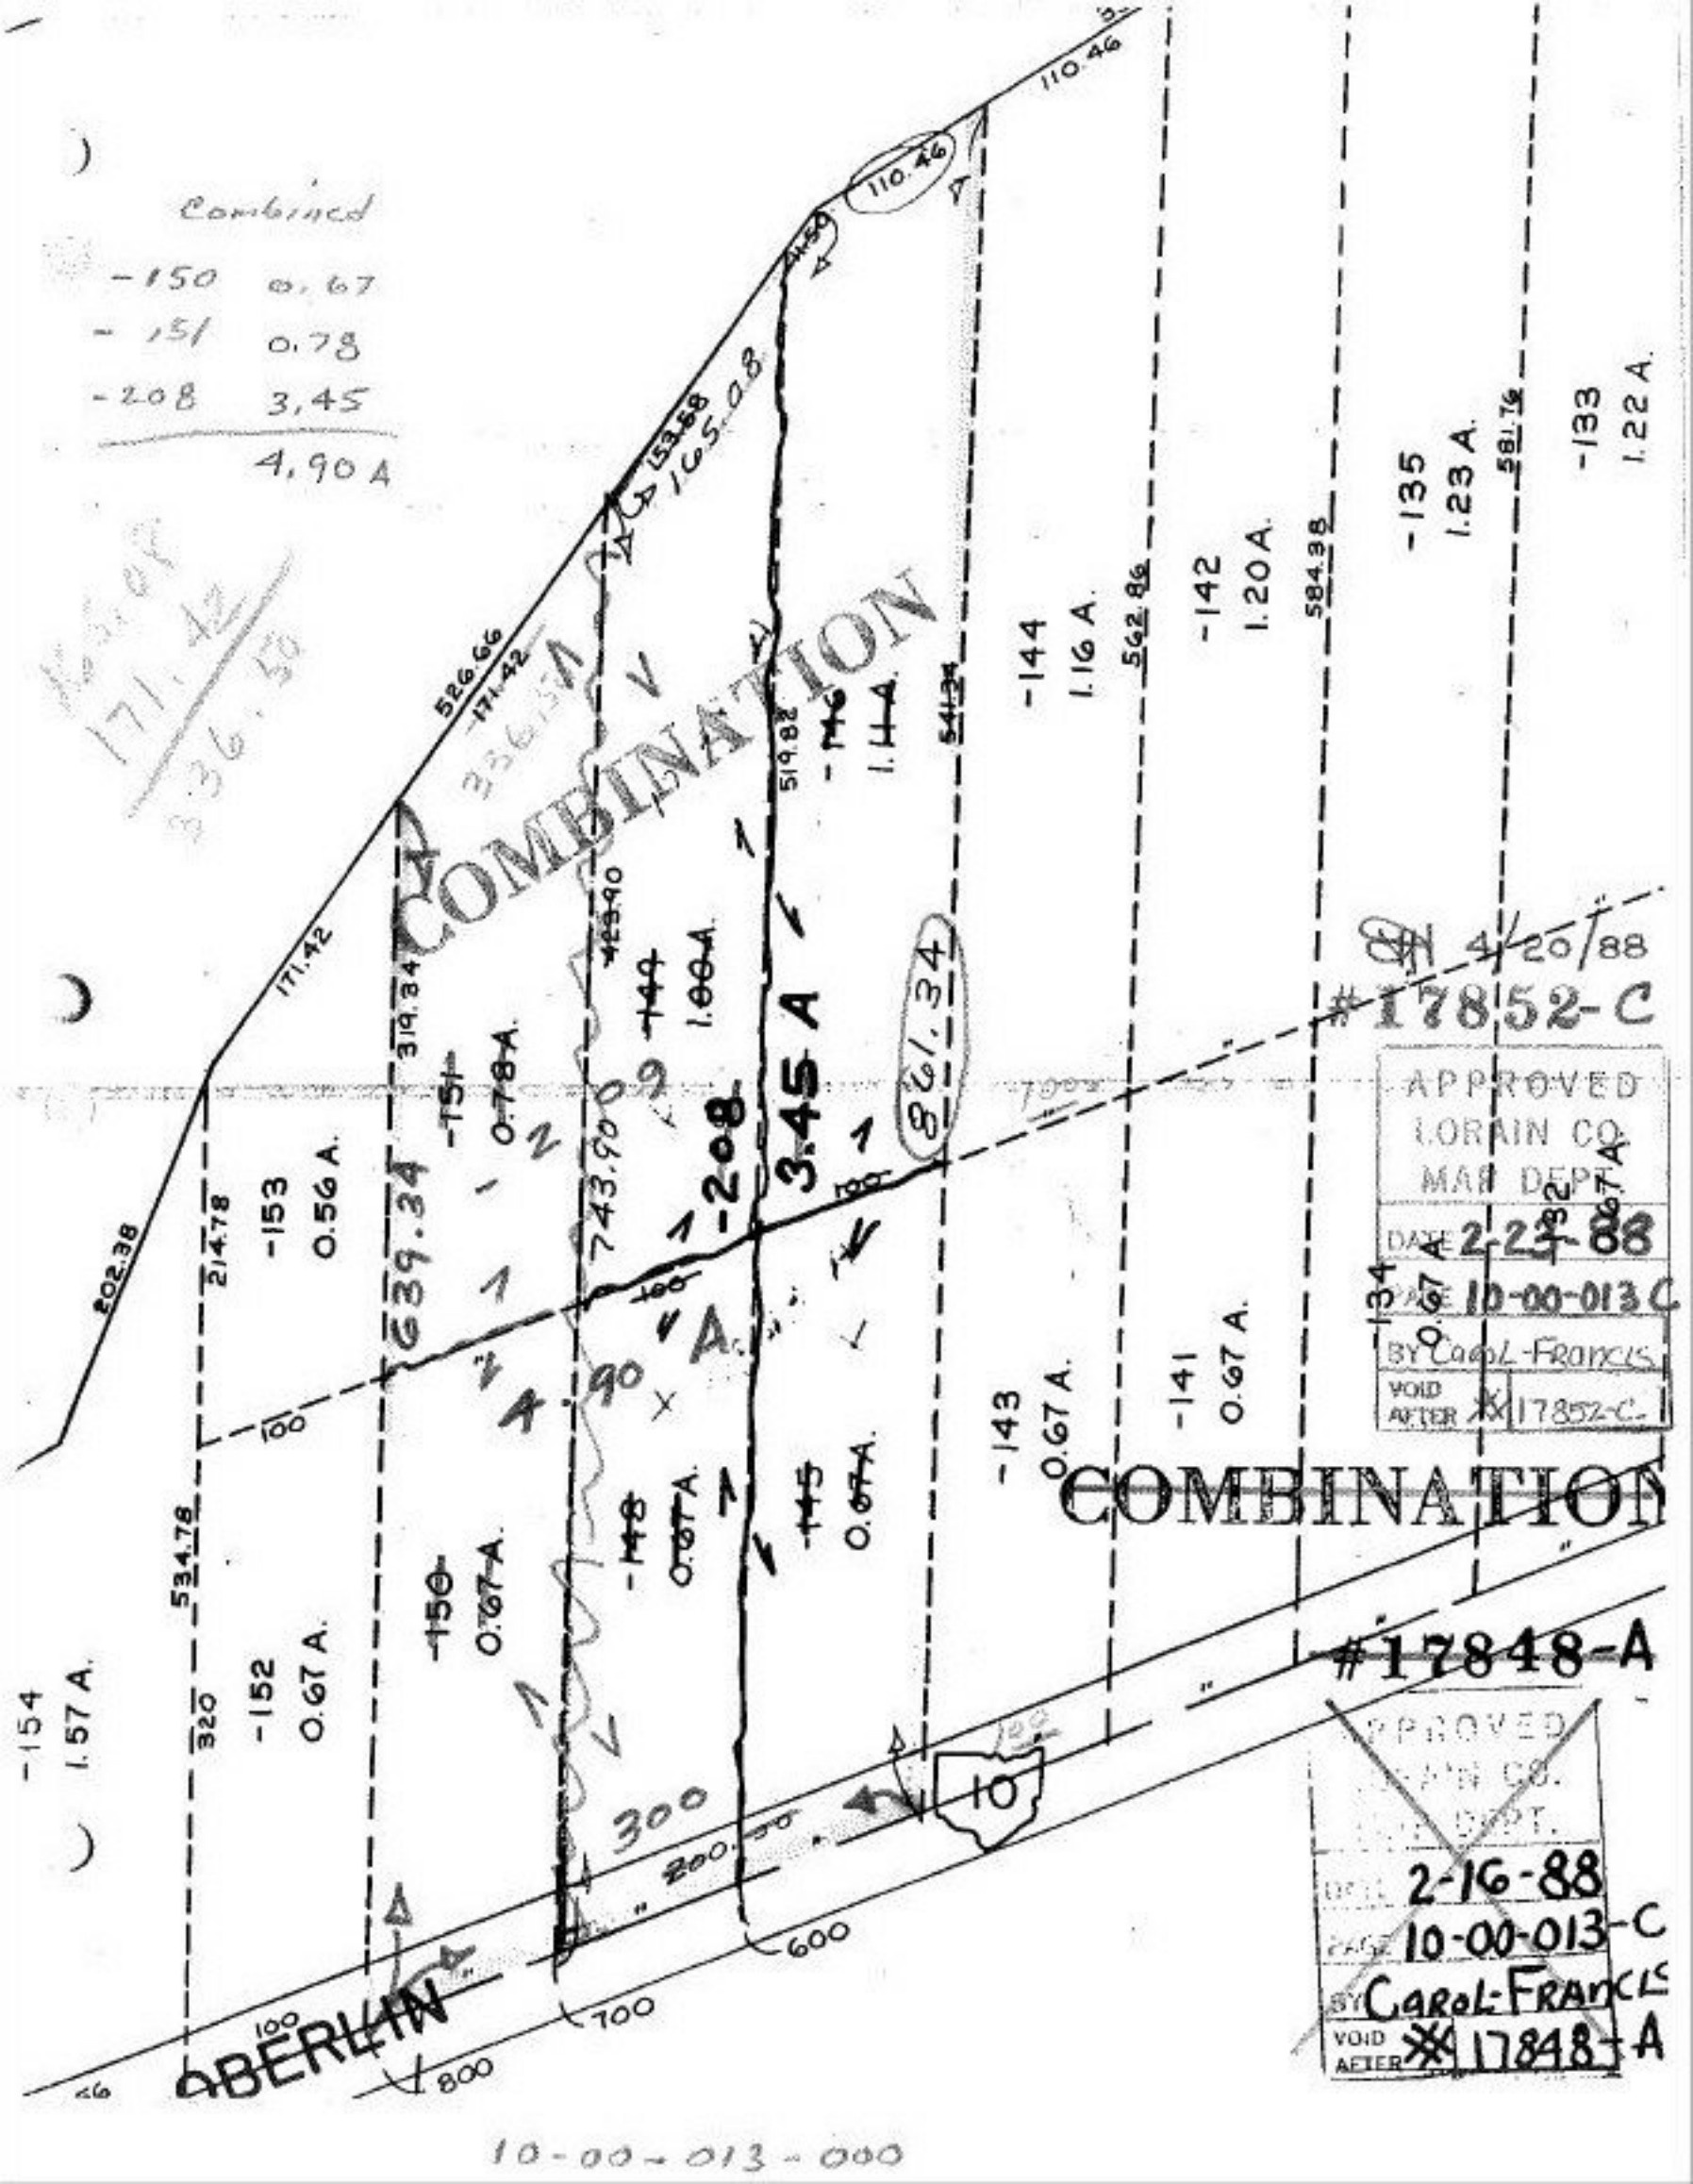

4/20/88  
#17852-C

APPROVED
LORAIN CO.
MAP DEPT.
DATE 2-23-88
BY Carol-Francis
VOID AFTER #17852-C

COMBINATION

#17848-A

APPROVED
LORAIN CO.
MAP DEPT.
DATE 2-16-88
BY Carol-Francis
VOID AFTER #17848-A