


SEE II-A

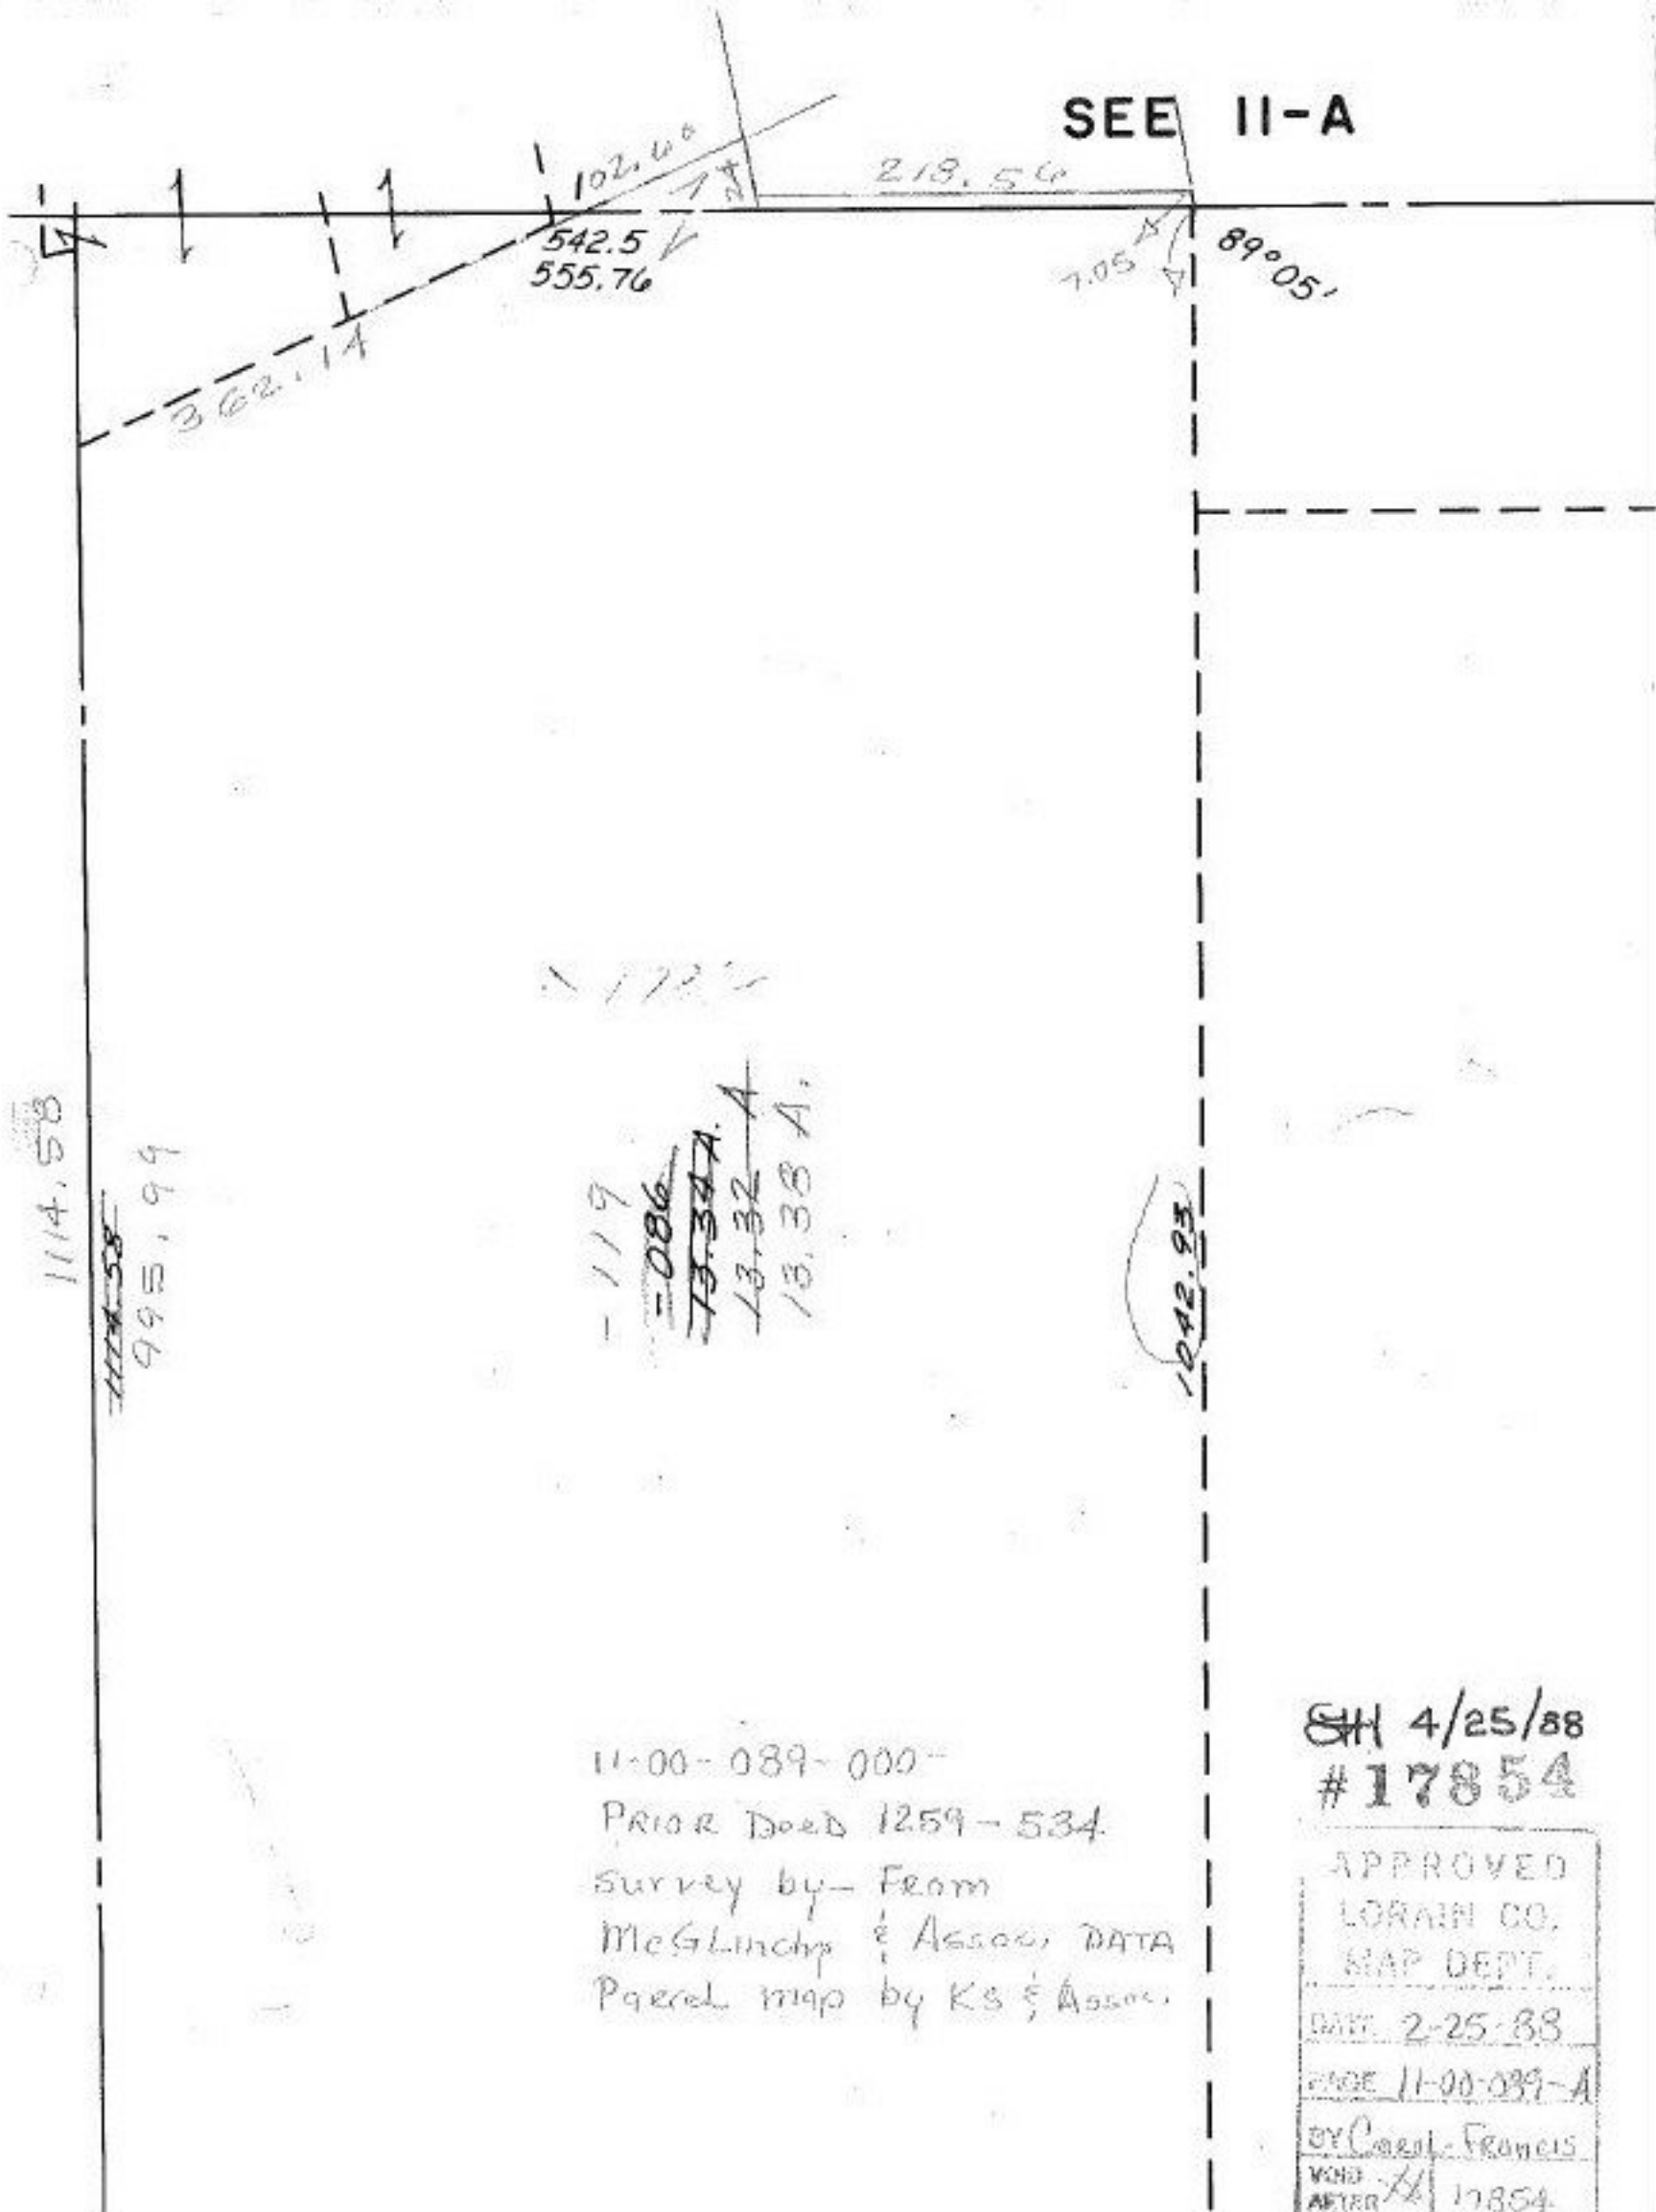

114.58
~~1174.58~~
 995.99

172

-119
 -086
 13.34 A
 13.32 A
 13.33 A

1042.93

11-00-089-000
 PRIOR Deed 1259-534
 Survey by - From
 McGlinchey & Assoc, DATA
 Parcel map by KS & Assoc.

SH 4/25/88
 #17854

APPROVED	
LORAIN CO. MAP DEPT.	
DATE	2-25-88
NO. 11-00-089-A	
BY	Carol Francis
VOID AFTER	17854