


426.16

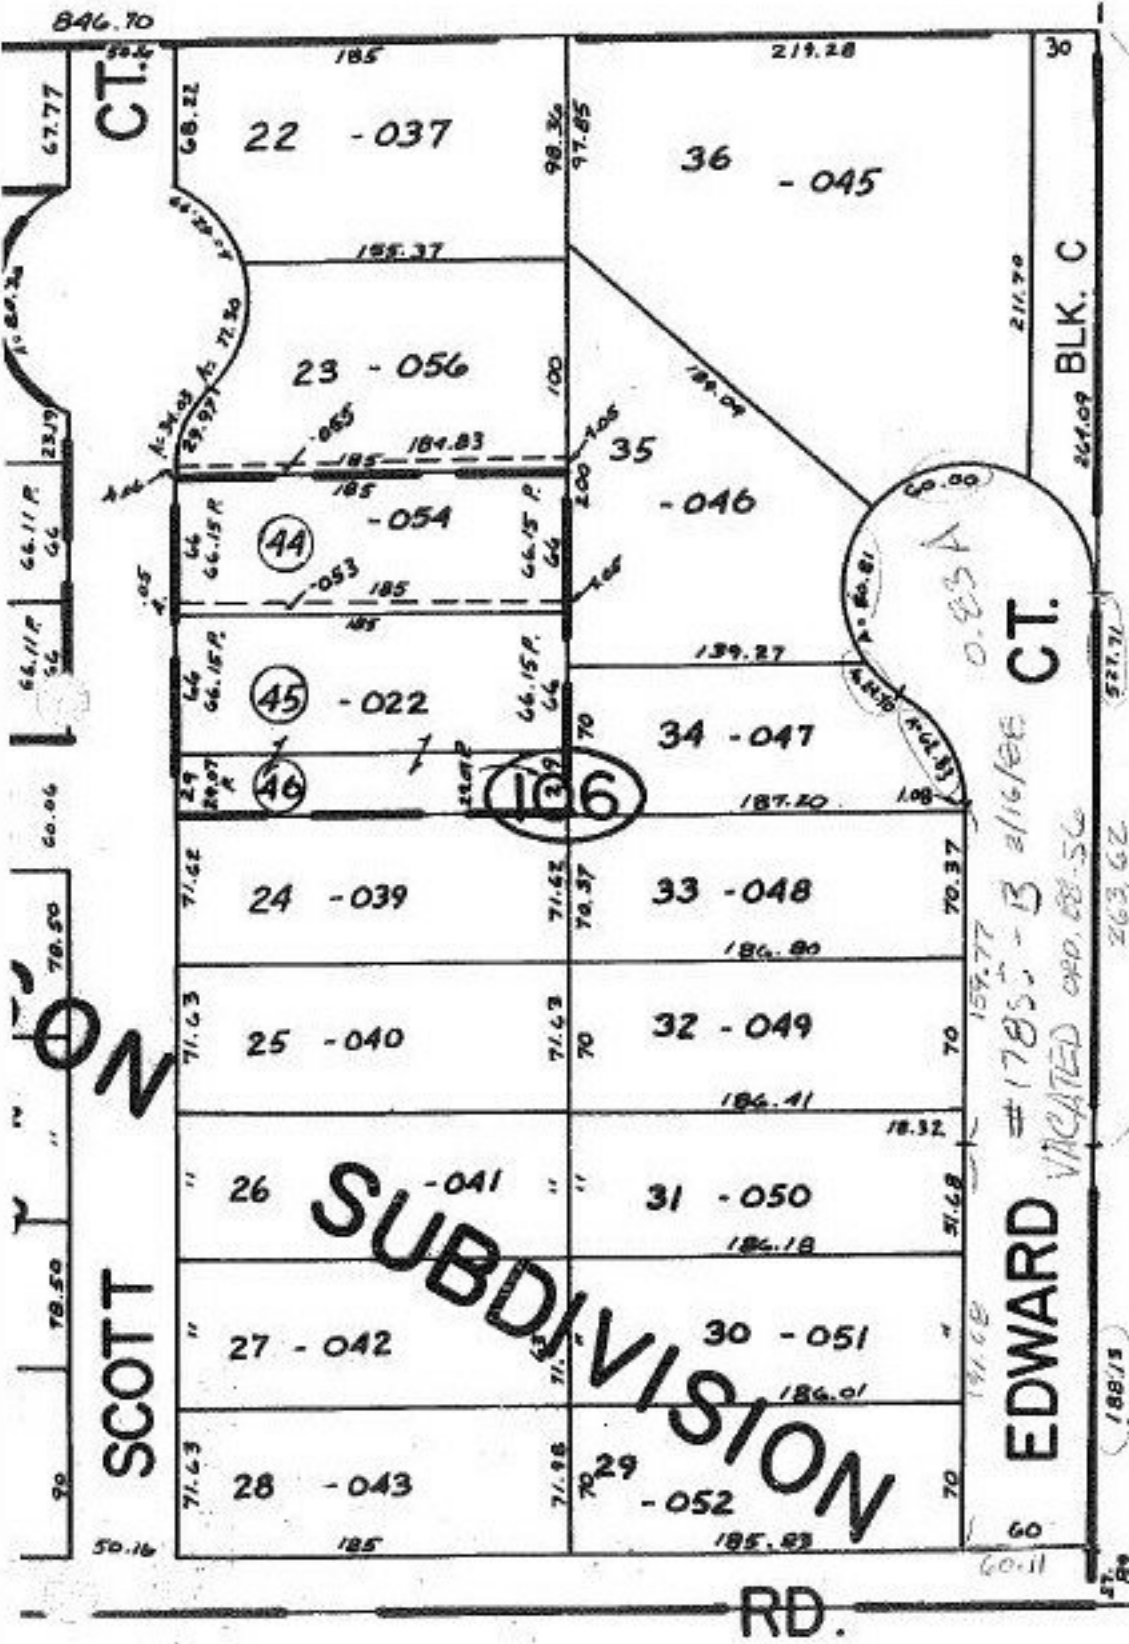

4/20/88
 ST. VAC.
 #17855-B

APPROVED	
LORAIN CO.	
MAP DEPT.	
DATE 3-1-88	
PAGE 10-60-004-A	
BY T. Moran	
9040	17855-B