


SEE 12-00-020-A

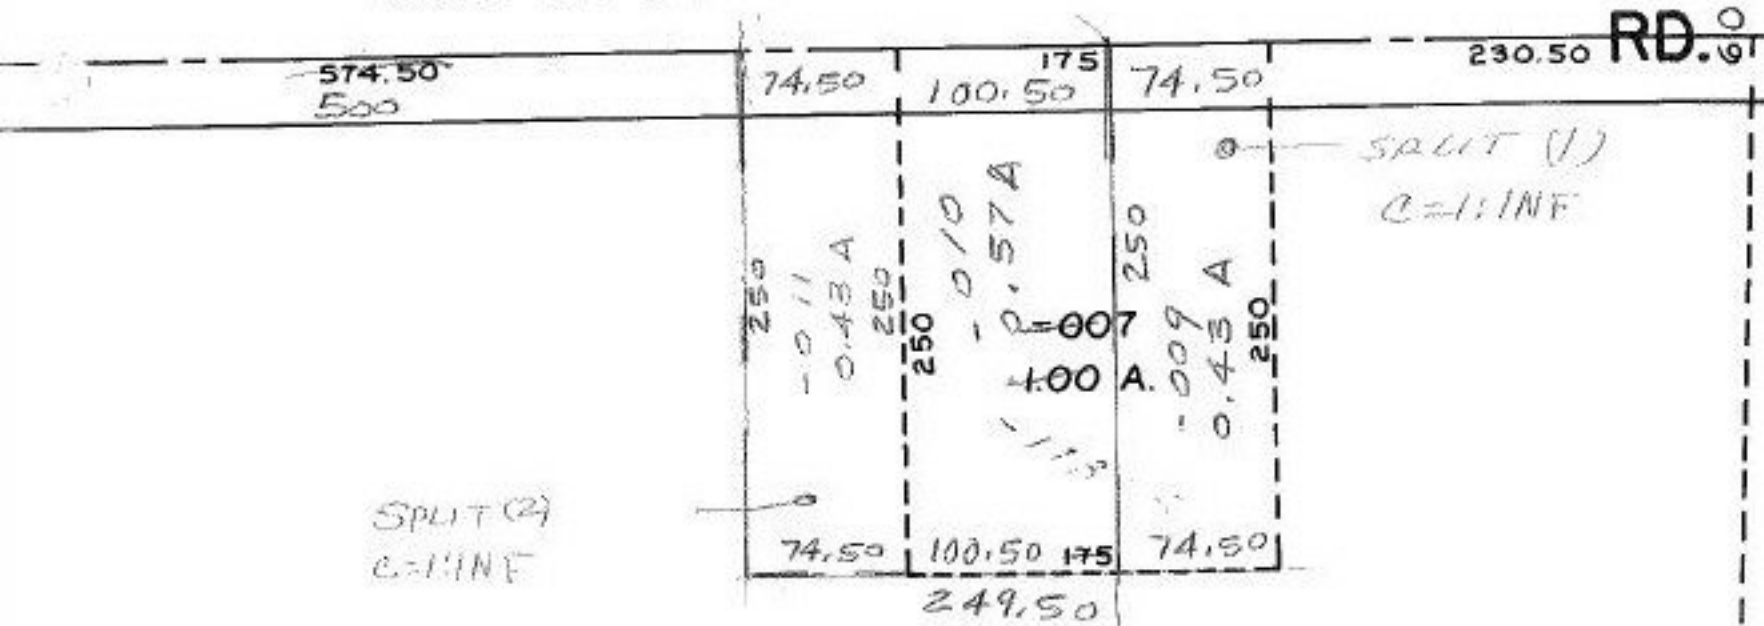

SPLIT (2)
C=LINE

SPLIT (1)
C=LINE

Pt. - 012

Pt. 93.87 Ac.

~~Pt. - 008~~

~~Pt. 94.30 A~~

12-00-019-000

Prior Ins.

(1) 1398-503 C=LINE

(2) 1412-751, 760 C=LINE

Survey by John G. Saylee
Reg. Surveyor

4/29/88

#17855

APPROVED	
LORAIN CO.	
MAP DEPT.	
DATE 2-25-88	
PAGE 12-00-019-A	
BY Carol-Francis	
VOID AFTER #	17855