


53.43 A.

-005  
28.19A.

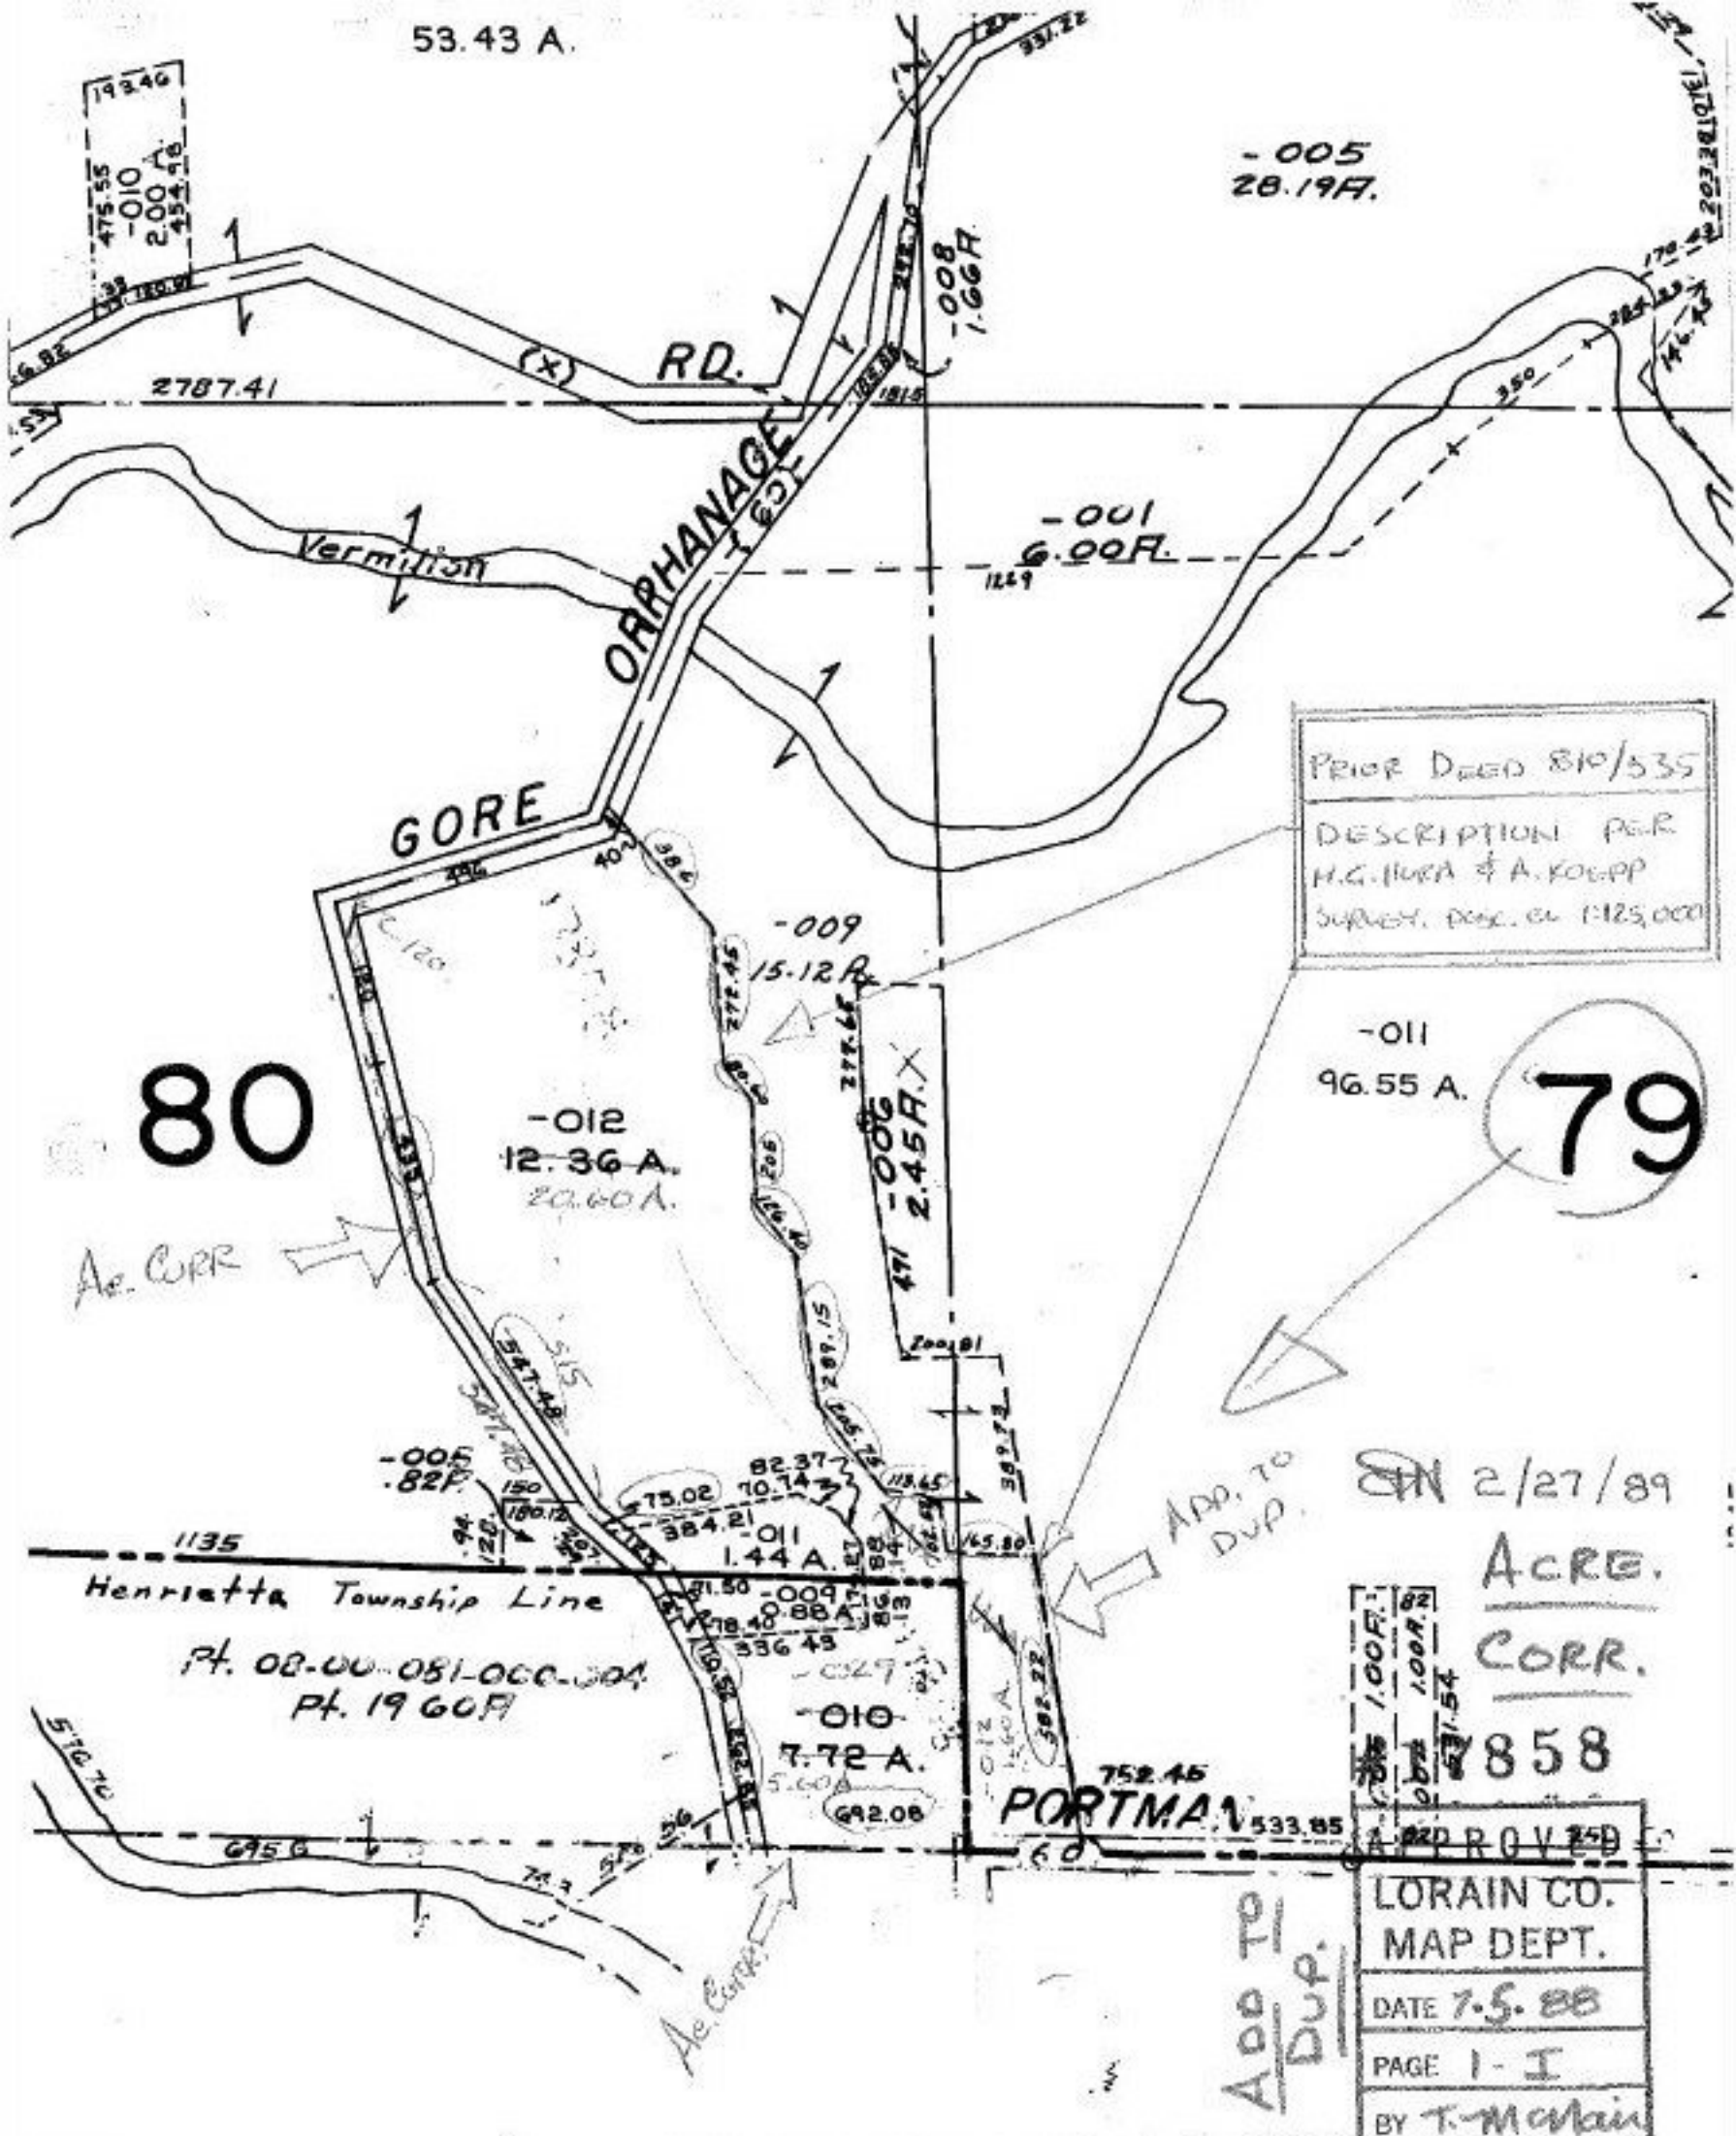

PRIOR DEED 810/535  
 DESCRIPTION PER  
 H.G. HURA & A. KOEPP  
 SURVEY, DEC. 04 1925, 000

-011  
 96.55 A. **79**

**80**

-012  
 12.36 A.  
 20.60 A.

-009  
 15.12 A.  
 -006  
 2.45 A.

-005  
 .82A.

-011  
 1.44 A.

-009  
 0.88 A.

-010  
 7.72 A.

Henrietta Township Line

Pt. 08-00-081-000-004  
 Pt. 1960A

PORTMAN  
 533.85

ADD. TO  
 DUP.

2/27/89  
 ACRE.  
 CORR.

1.00A.  
 1.00A.  
 531.54  
**858**

APPROVED  
 LORAIN CO.  
 MAP DEPT.  
 DATE 7.5.88  
 PAGE 1-I  
 BY T. McMan  
 VID AFTER #17258