


- 047
1.90A.

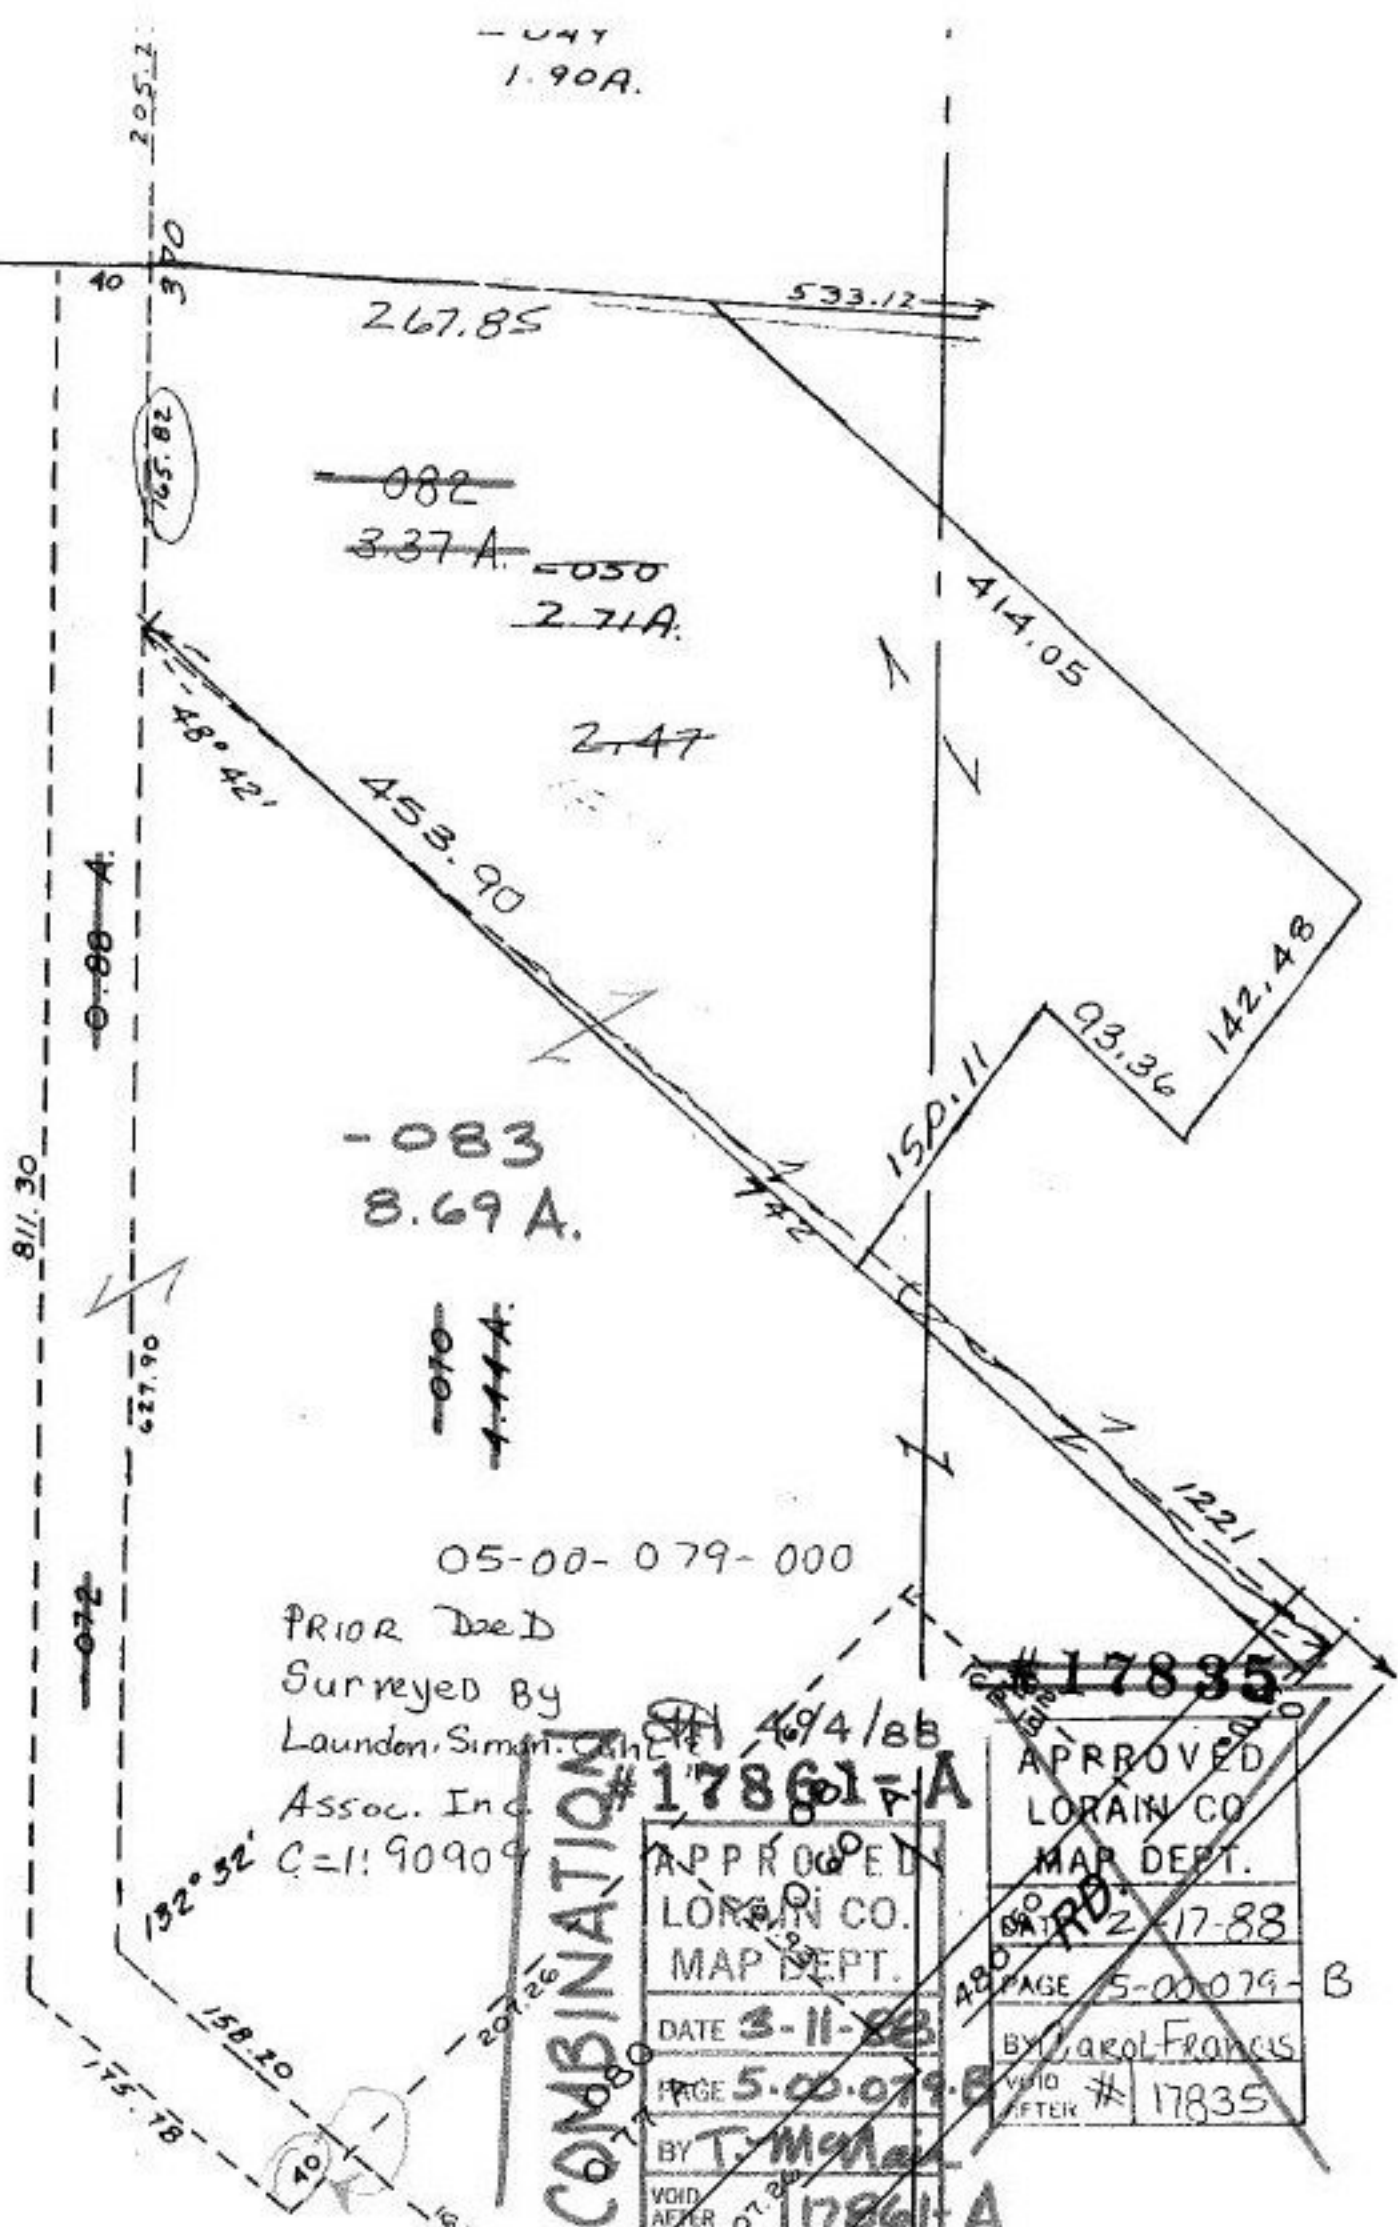

~~082~~
~~337 A.~~ = 050
2.71A.

2.47

- 083
8.69 A.

~~070~~
~~1.11A.~~

05-00-079-000

PRIOR Deed
Surreyed By
Launden, Simon, C. & H.
Assoc. Inc.
C=1:9090

COMBINATION

4/4/88
#17861-A
APPROVED
LORAIN CO.
MAP DEPT.
DATE 3-11-88
PAGE 5-00-079-B
BY T. McNamee
VOID AFTER #17861-A

~~#17835~~
APPROVED
LORAIN CO.
MAP DEPT.
DATE 2-17-88
PAGE 5-00-079-B
BY Carol Francis
VOID AFTER #17835