
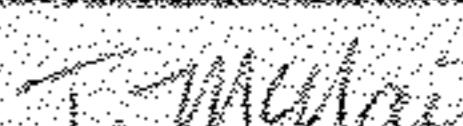


SEE 6-107

ACRE. C6RR.

#17864

APPROVED	LORAIN CO.
MAP DEPT.	
DATE 3-10-88	
PAGE 6-106	
BY 	
VOID	17864
AFTER	

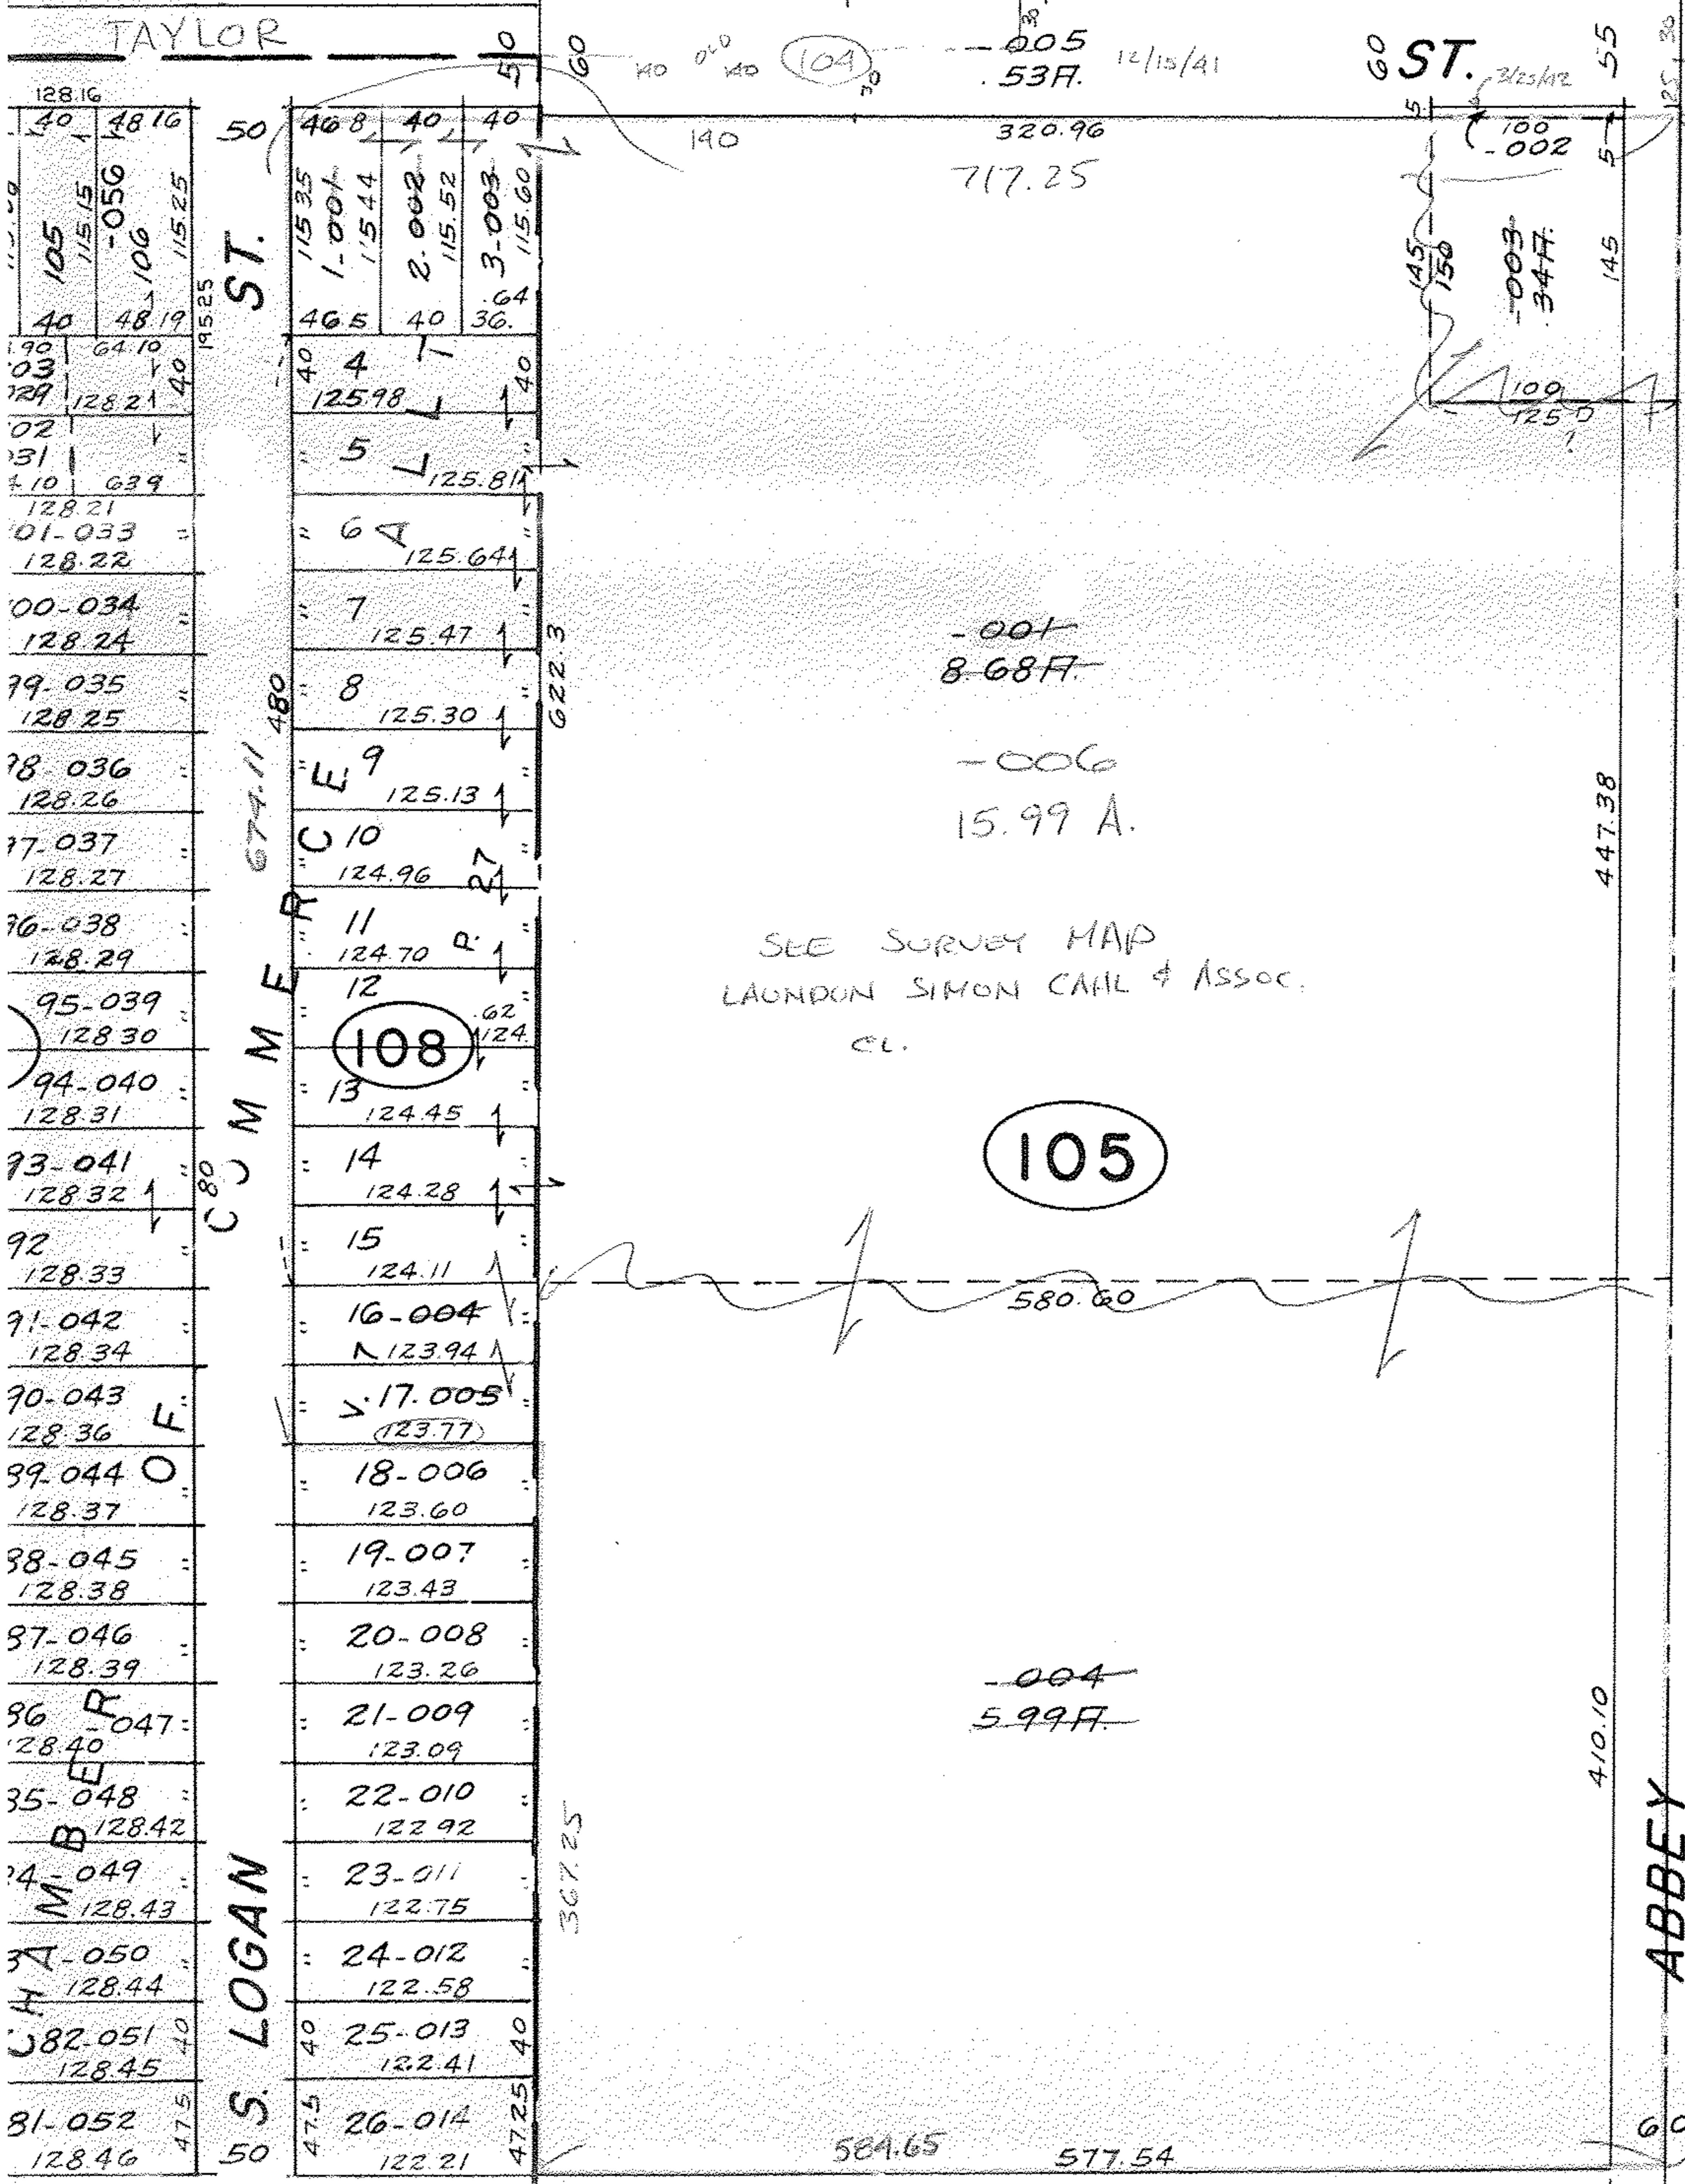

SM 4/6/88

ACRE, CORP.

#17864

APPROVED	LORAIN CO.
MAP DEPT.	
DATE 3-10-88	
PAGE 6-106	
BY T. McNamee	
VOID AFTER	17864