

1487.69


1117.69

-015

-012

5.89 A.

6.95 A.

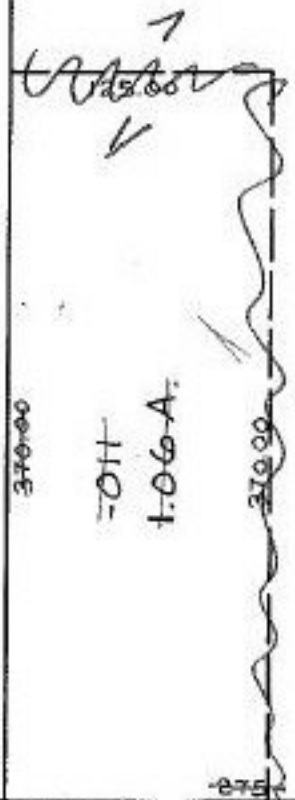

-011

1.06 A.

275

REDFERN

-002

3.34 A.

1118

-003

3.34 A.

520.2

-005

1.19 A.

519.44

-007

2.35 A.

123

COMBINATION

12-00-020-123

4/29/88

17866-B

APPROVED
LORAIN CO.
MAP DEPT.

DATE 3-15-88

PAGE 12-00-020-B

BY CAROL-FRANCIS

17866-A

SEE 12-