


SEE 12-00-040-B

Rocky

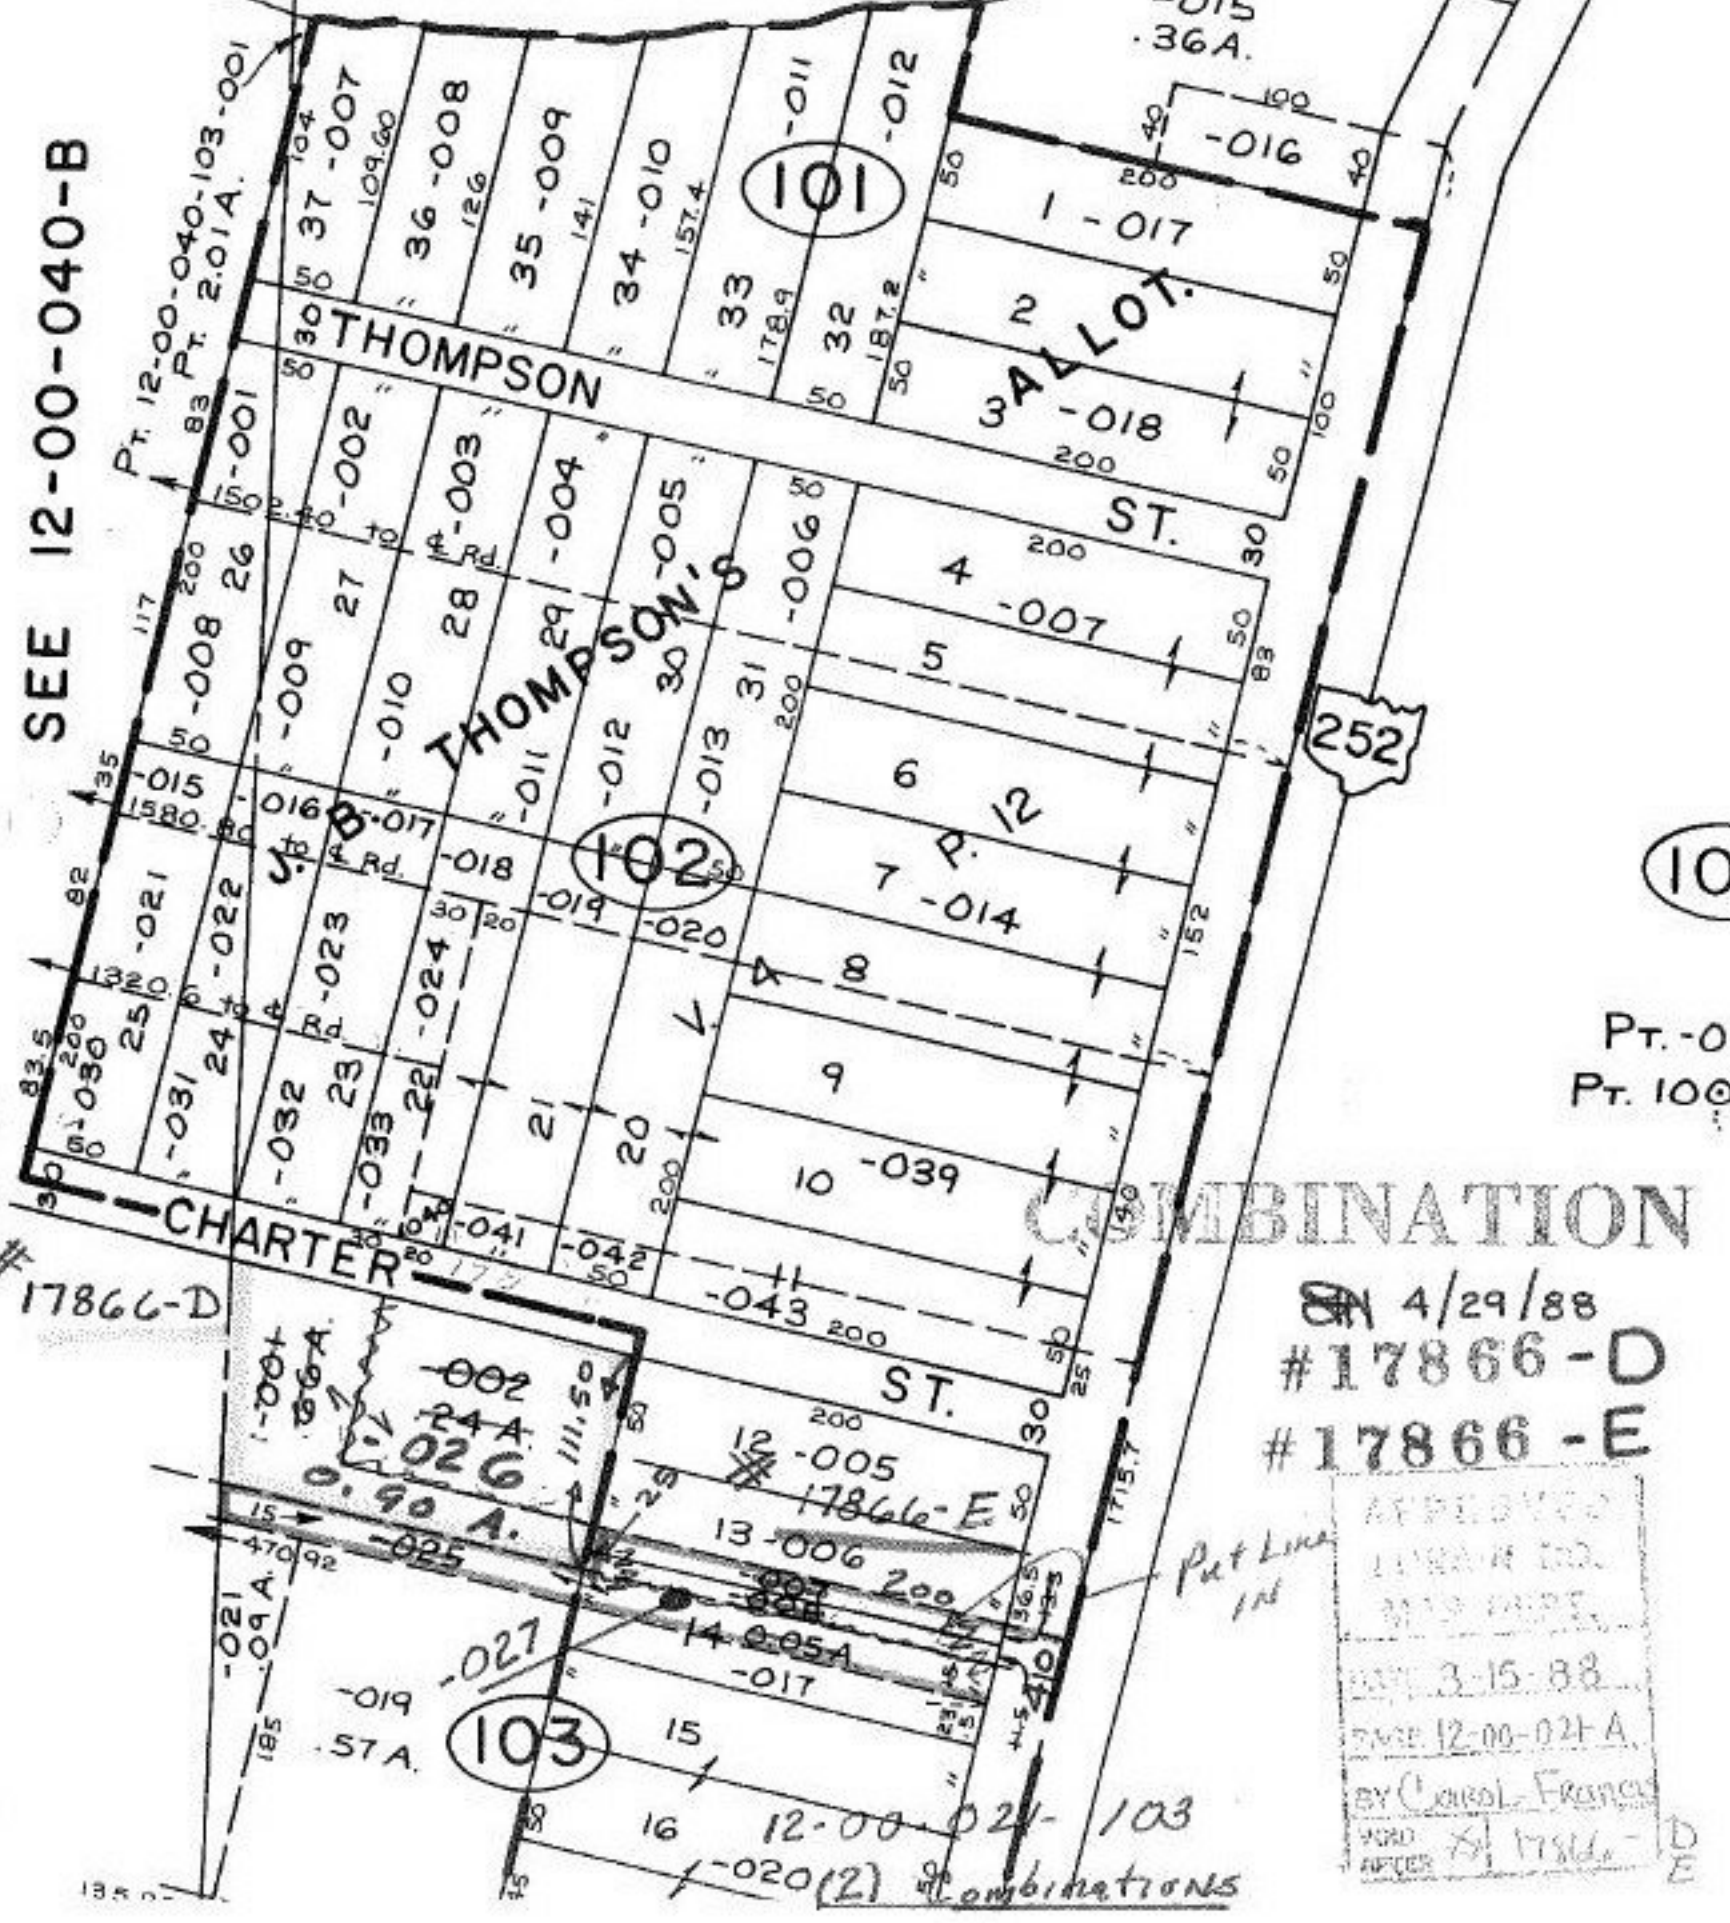

4/29/88  
 #17866-D  
 #17866-E

APPROVED  
 TOWN OF  
 M13 PAPER  
 DATE 3-15-88  
 CASE 12-00-021-A  
 BY Carol Francis  
 VORD OFFICER #17866-D  
 E

12-00-021-103  
 1-020(2) combinations