

-002  
3.57A.

1502.40 TO & RD.

~~003~~  
~~2.06A.~~

1580.80 TO & RD.

1320.60 TO & RD.

SEE 12-00-02-A


103

014  
43.32 A

Combined

-003	2.06
-004	5.92
-013	23.91
-011	11.43
<hr/>	
	43.32 A

~~013~~  
~~23.91A~~

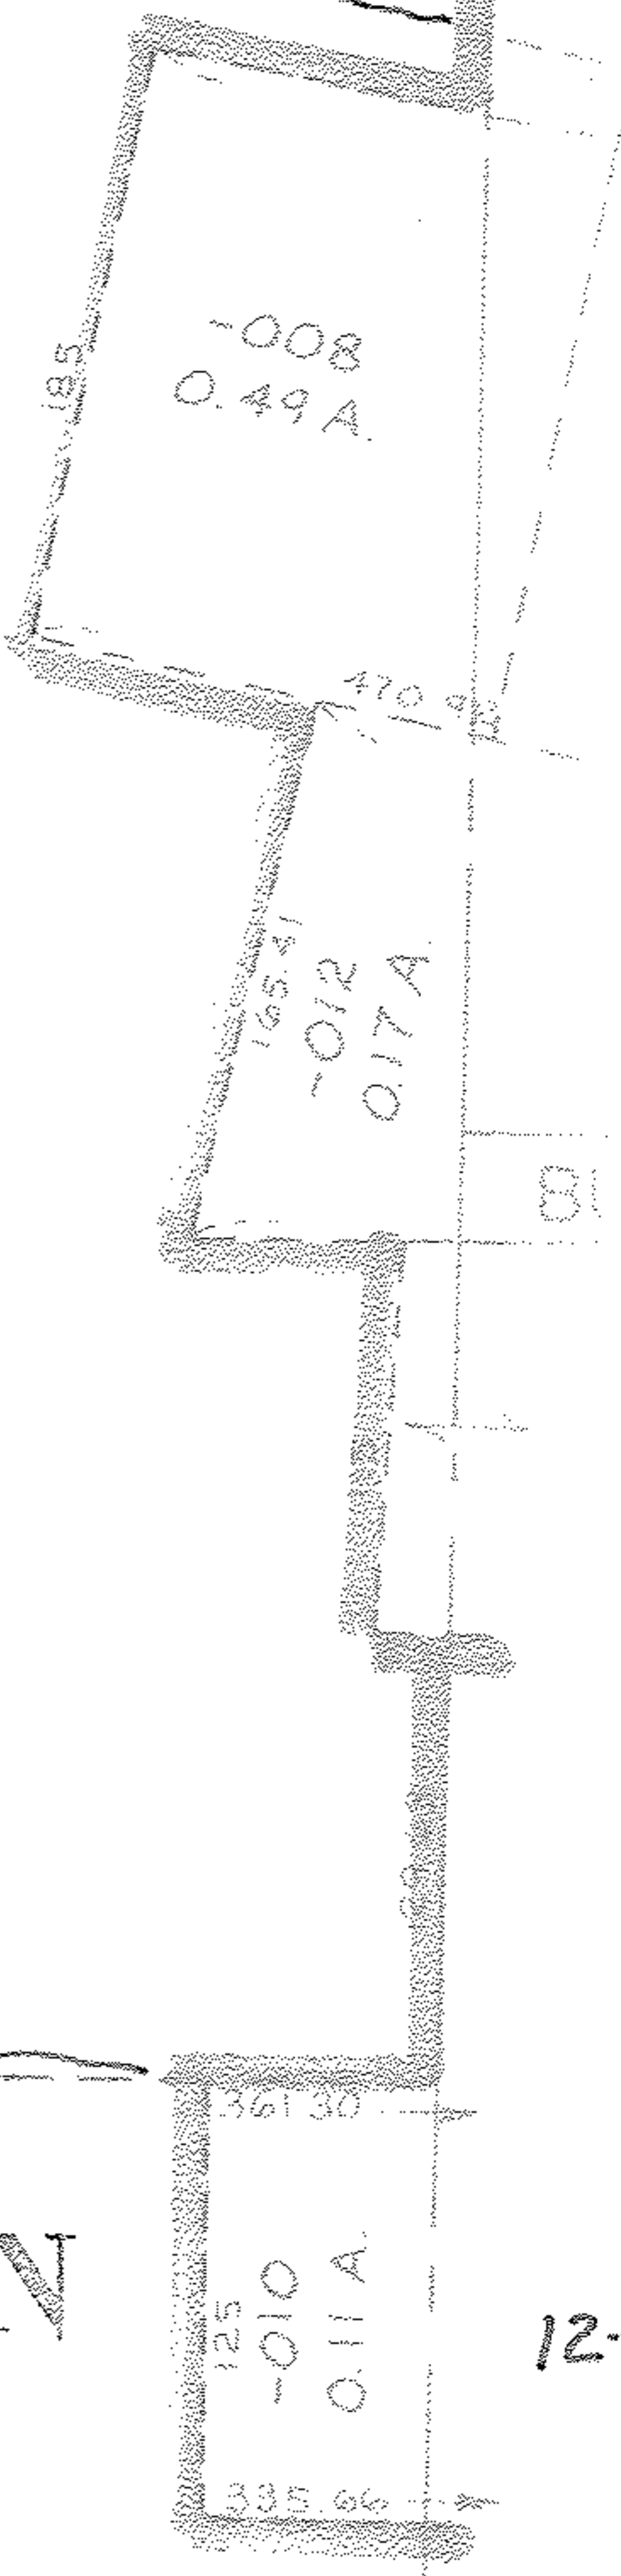

# COMBINATION

ON 4/29/88

#17867-A

• Pt. ~~011~~  
Pt. H. ~~43A~~

12-00-040-103

APPROVED LORAIN CO. MAP DEPT.
DATE 3-15-88
PAGE 12-00-040-B
BY Carol-FRANCIS
VOID AFTER <del>X</del> 17867-A

#  
A  
L  
R  
DAT  
PAC  
BY  
VO  
AFT