


20

(VERMILION RD.)

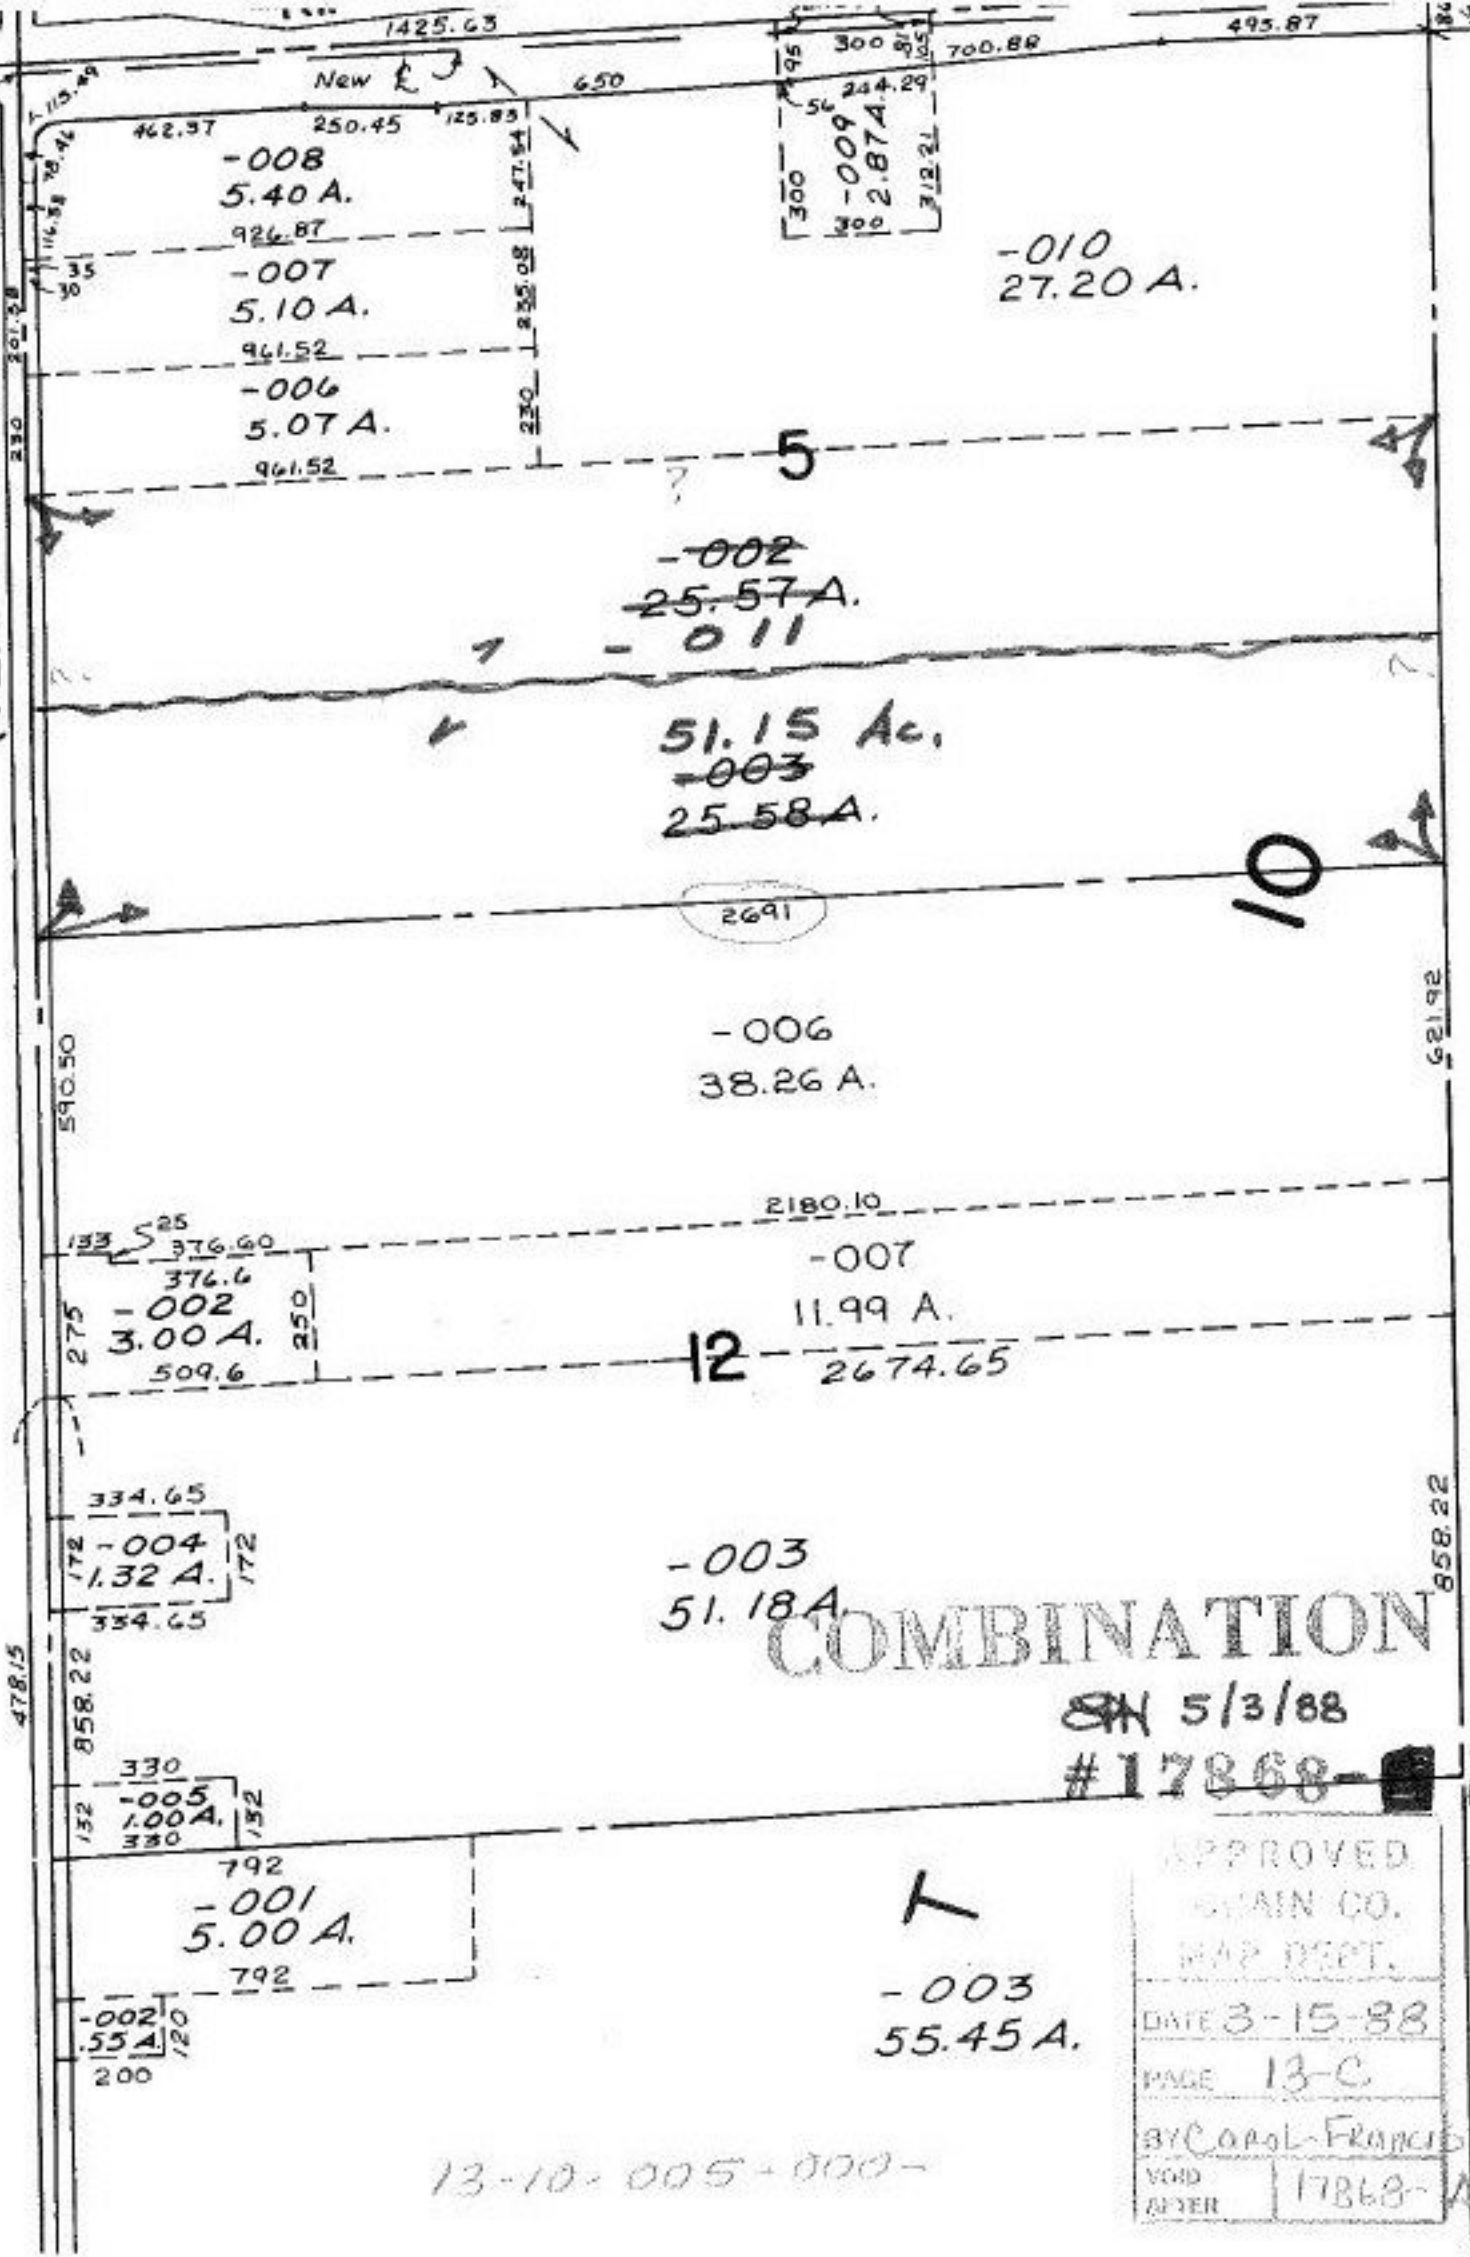

COMBINATION

SN 5/3/88

#17868-B

APPROVED
STAIN CO.
MAP DEPT.
DATE 3-15-88
PAGE 13-C
BY Carol-Franco
VOID AFTER 17868-A

-003
55.45 A.

13-10-005-000-