


AKINS

RD. 500

60

60

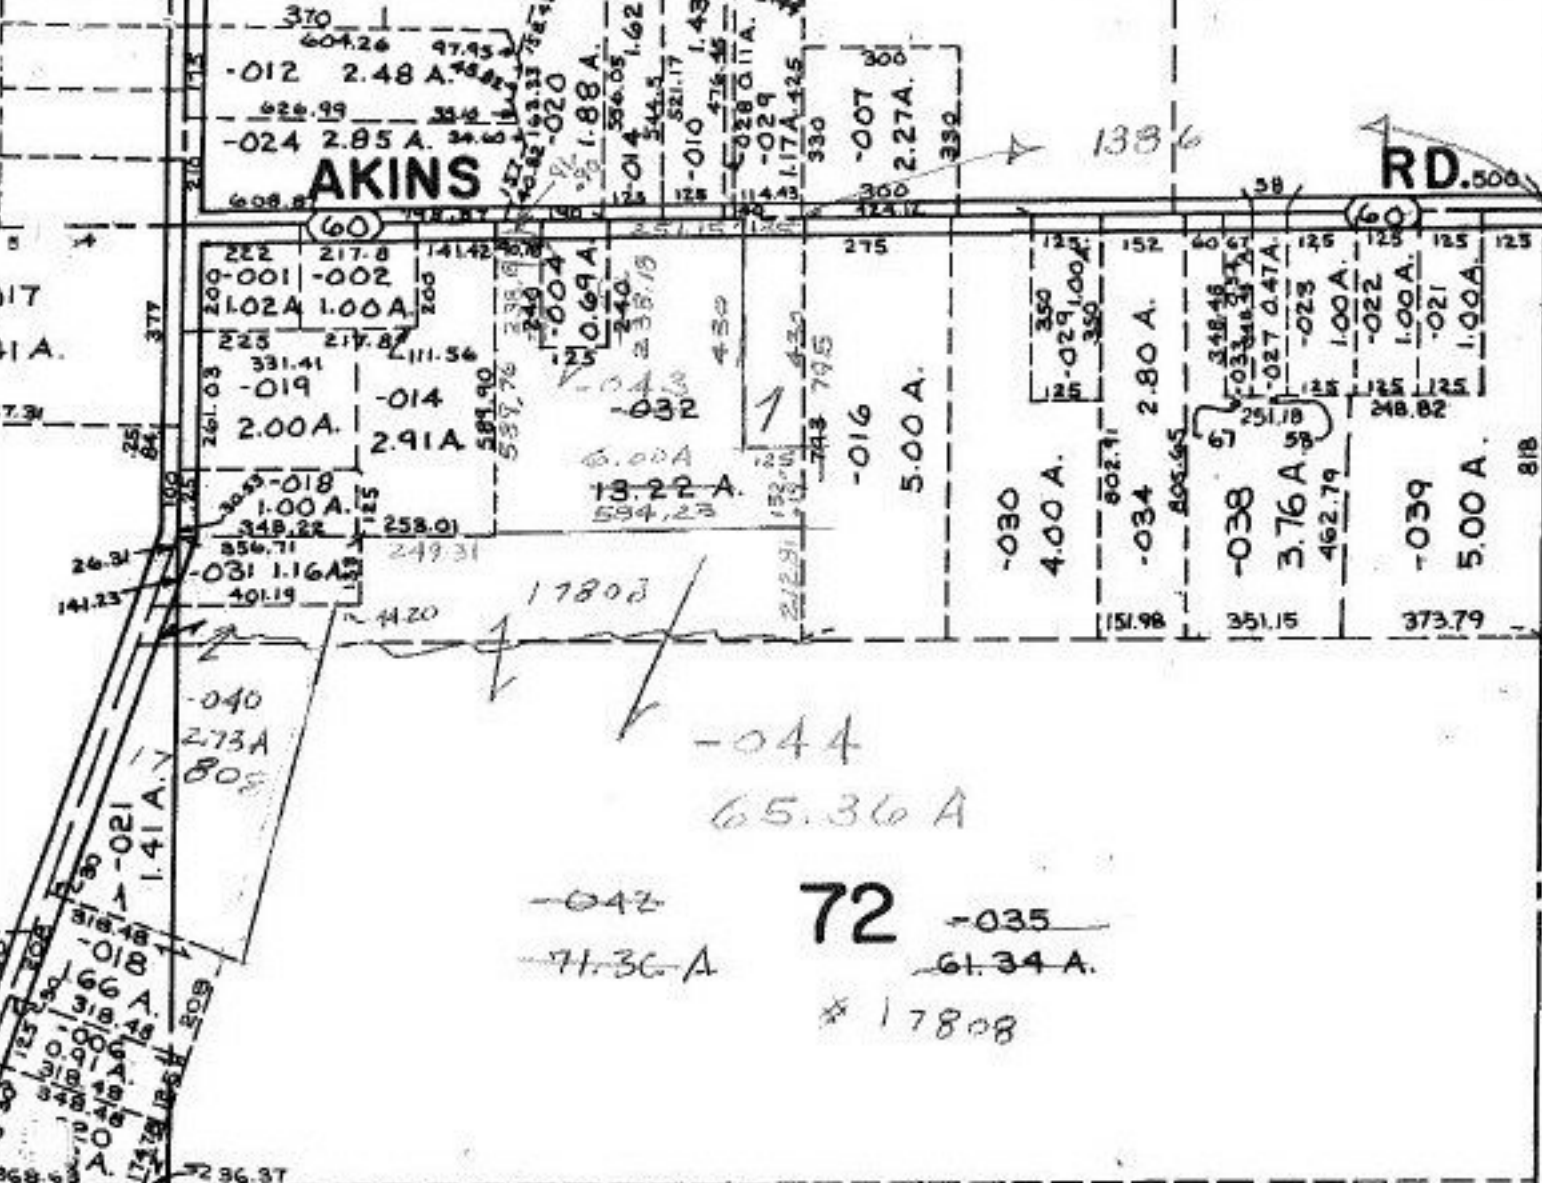

72

-044
65.36 A

-042
71-36-A

-035
61.34 A.

* 17808

-007
50.00 A.

12-00-072-000
PRIOR DEED 300-130
Survey By: KS-A
C=1:500,000

-001
25.00 A.

4/29/88
#17868

-006
8.31 A.

-003
39.94 A

APPROVED
LORAIN CO.
MAP DEPT.
DATE 3- ²⁴ 88
PAGE 12-E
BY <i>Coyl-Francis</i>
VOID AFTER <i>X</i> 17868

-014

1356.30
976.61