


SEE 12-00-040-B

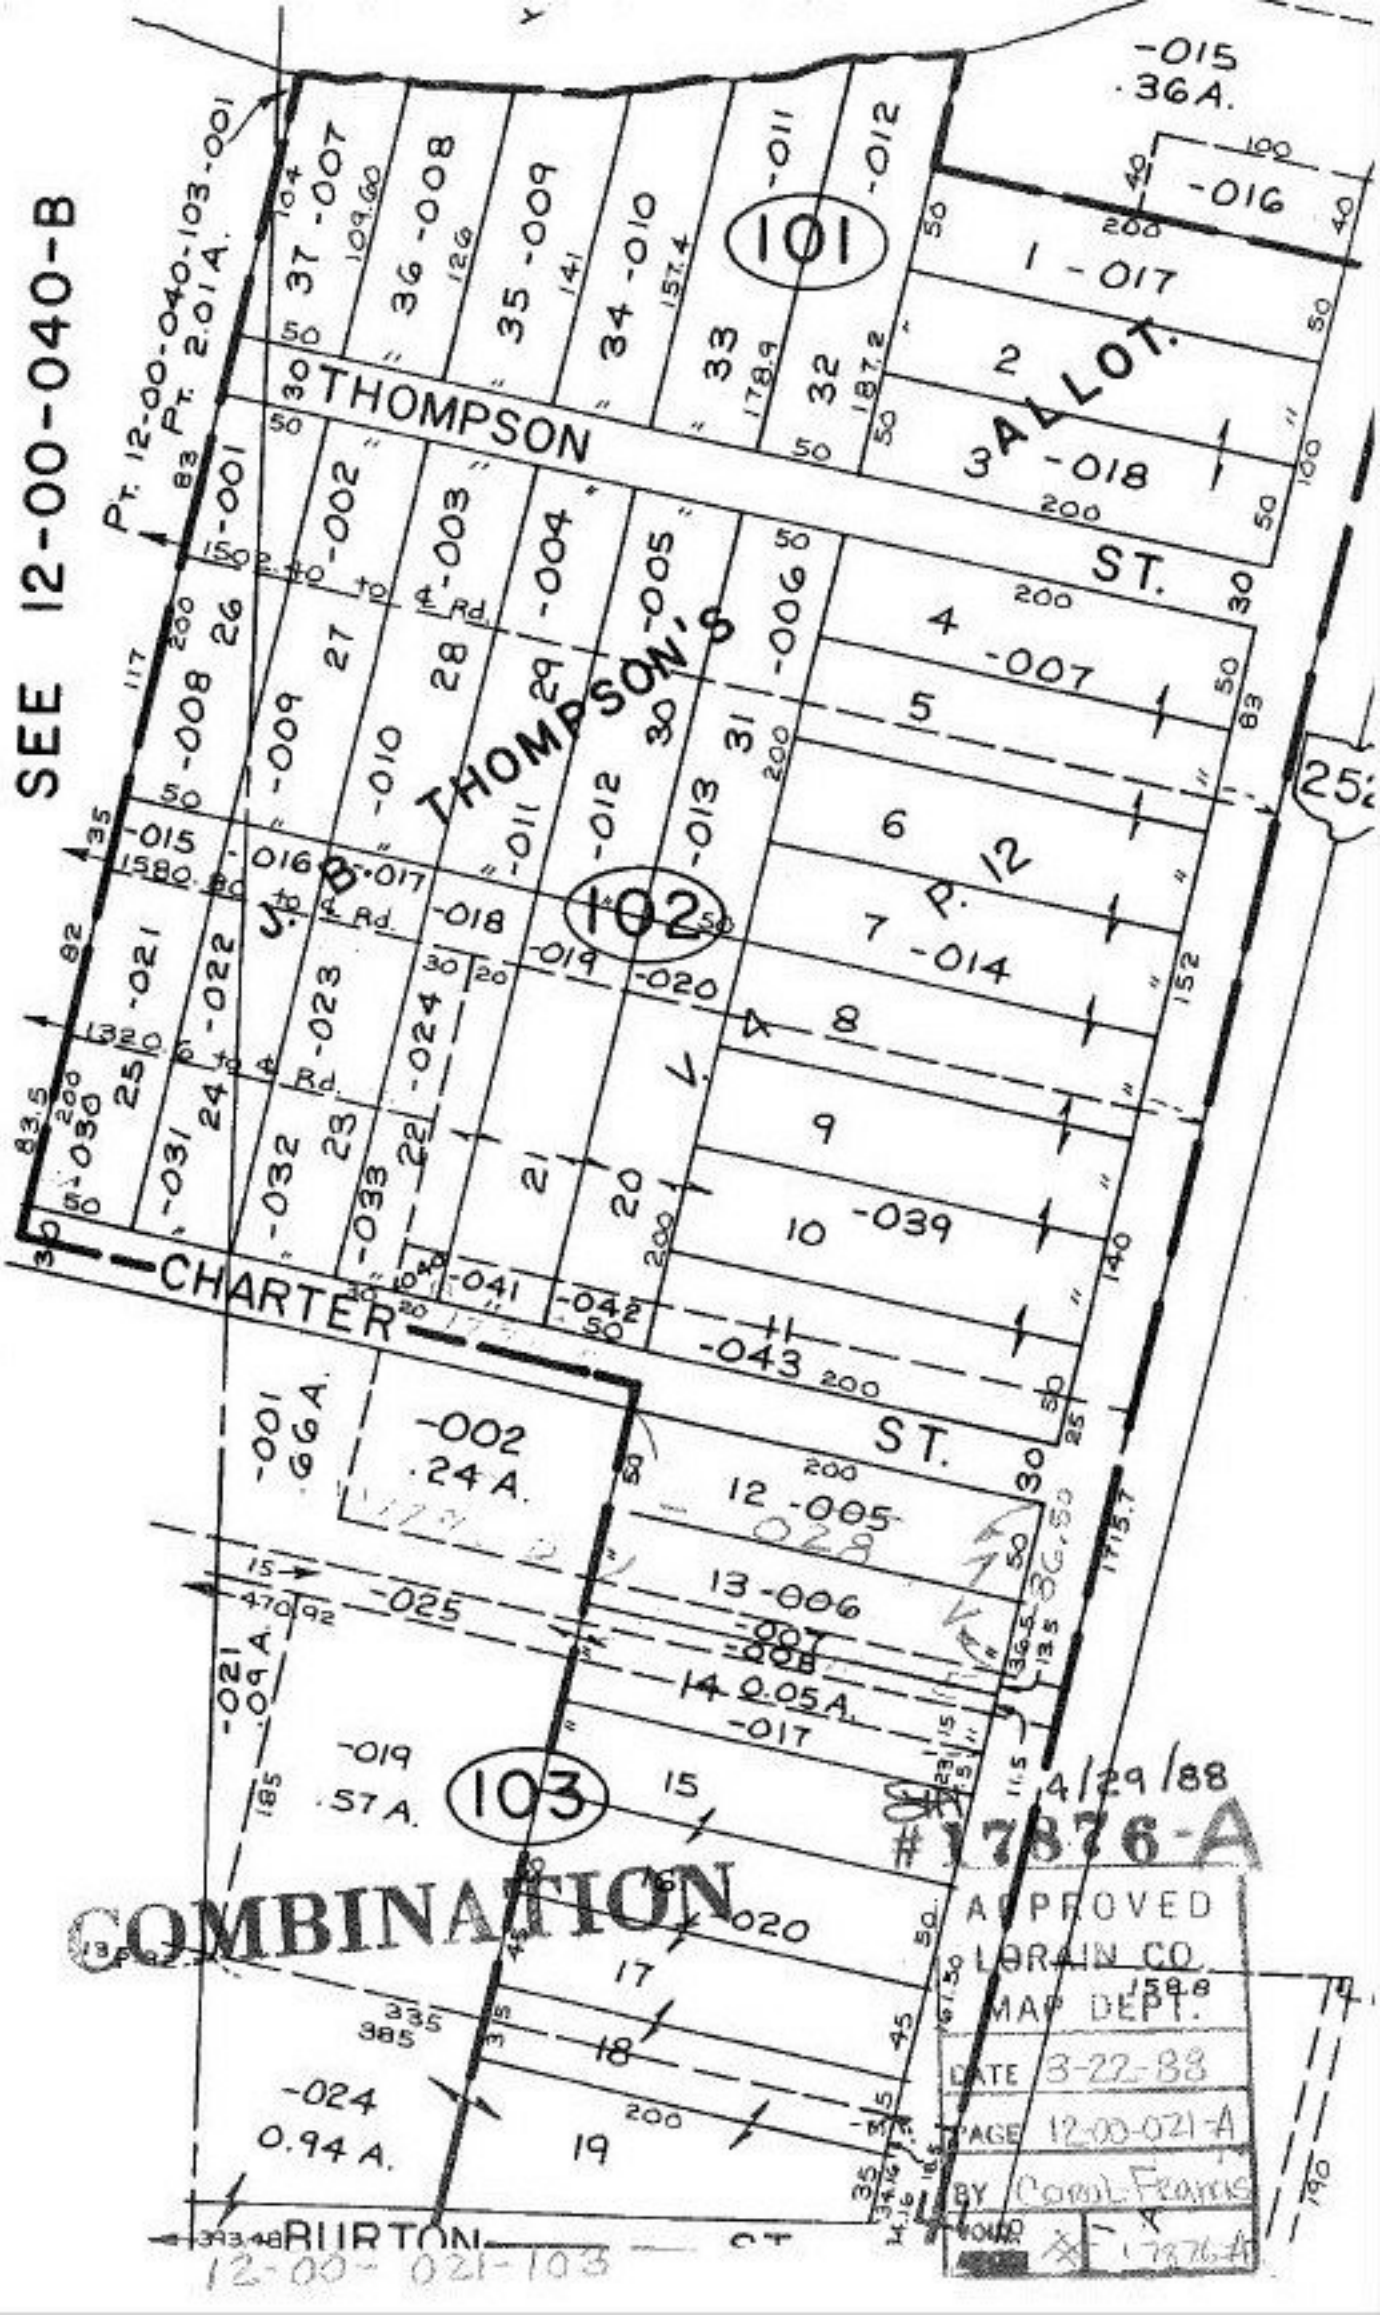

36.50
50.

86.50

APPROVED
LORAIN CO.
MAP DEPT.
DATE 3-22-88
PAGE 12-00-021-A
BY CORIN FRANKS
17876-A

COMBINATION

RIURTON
12-00-021-103

190