


SEE

5-00-058-B

VALLEY NO. 4 SUB.

NO. 6

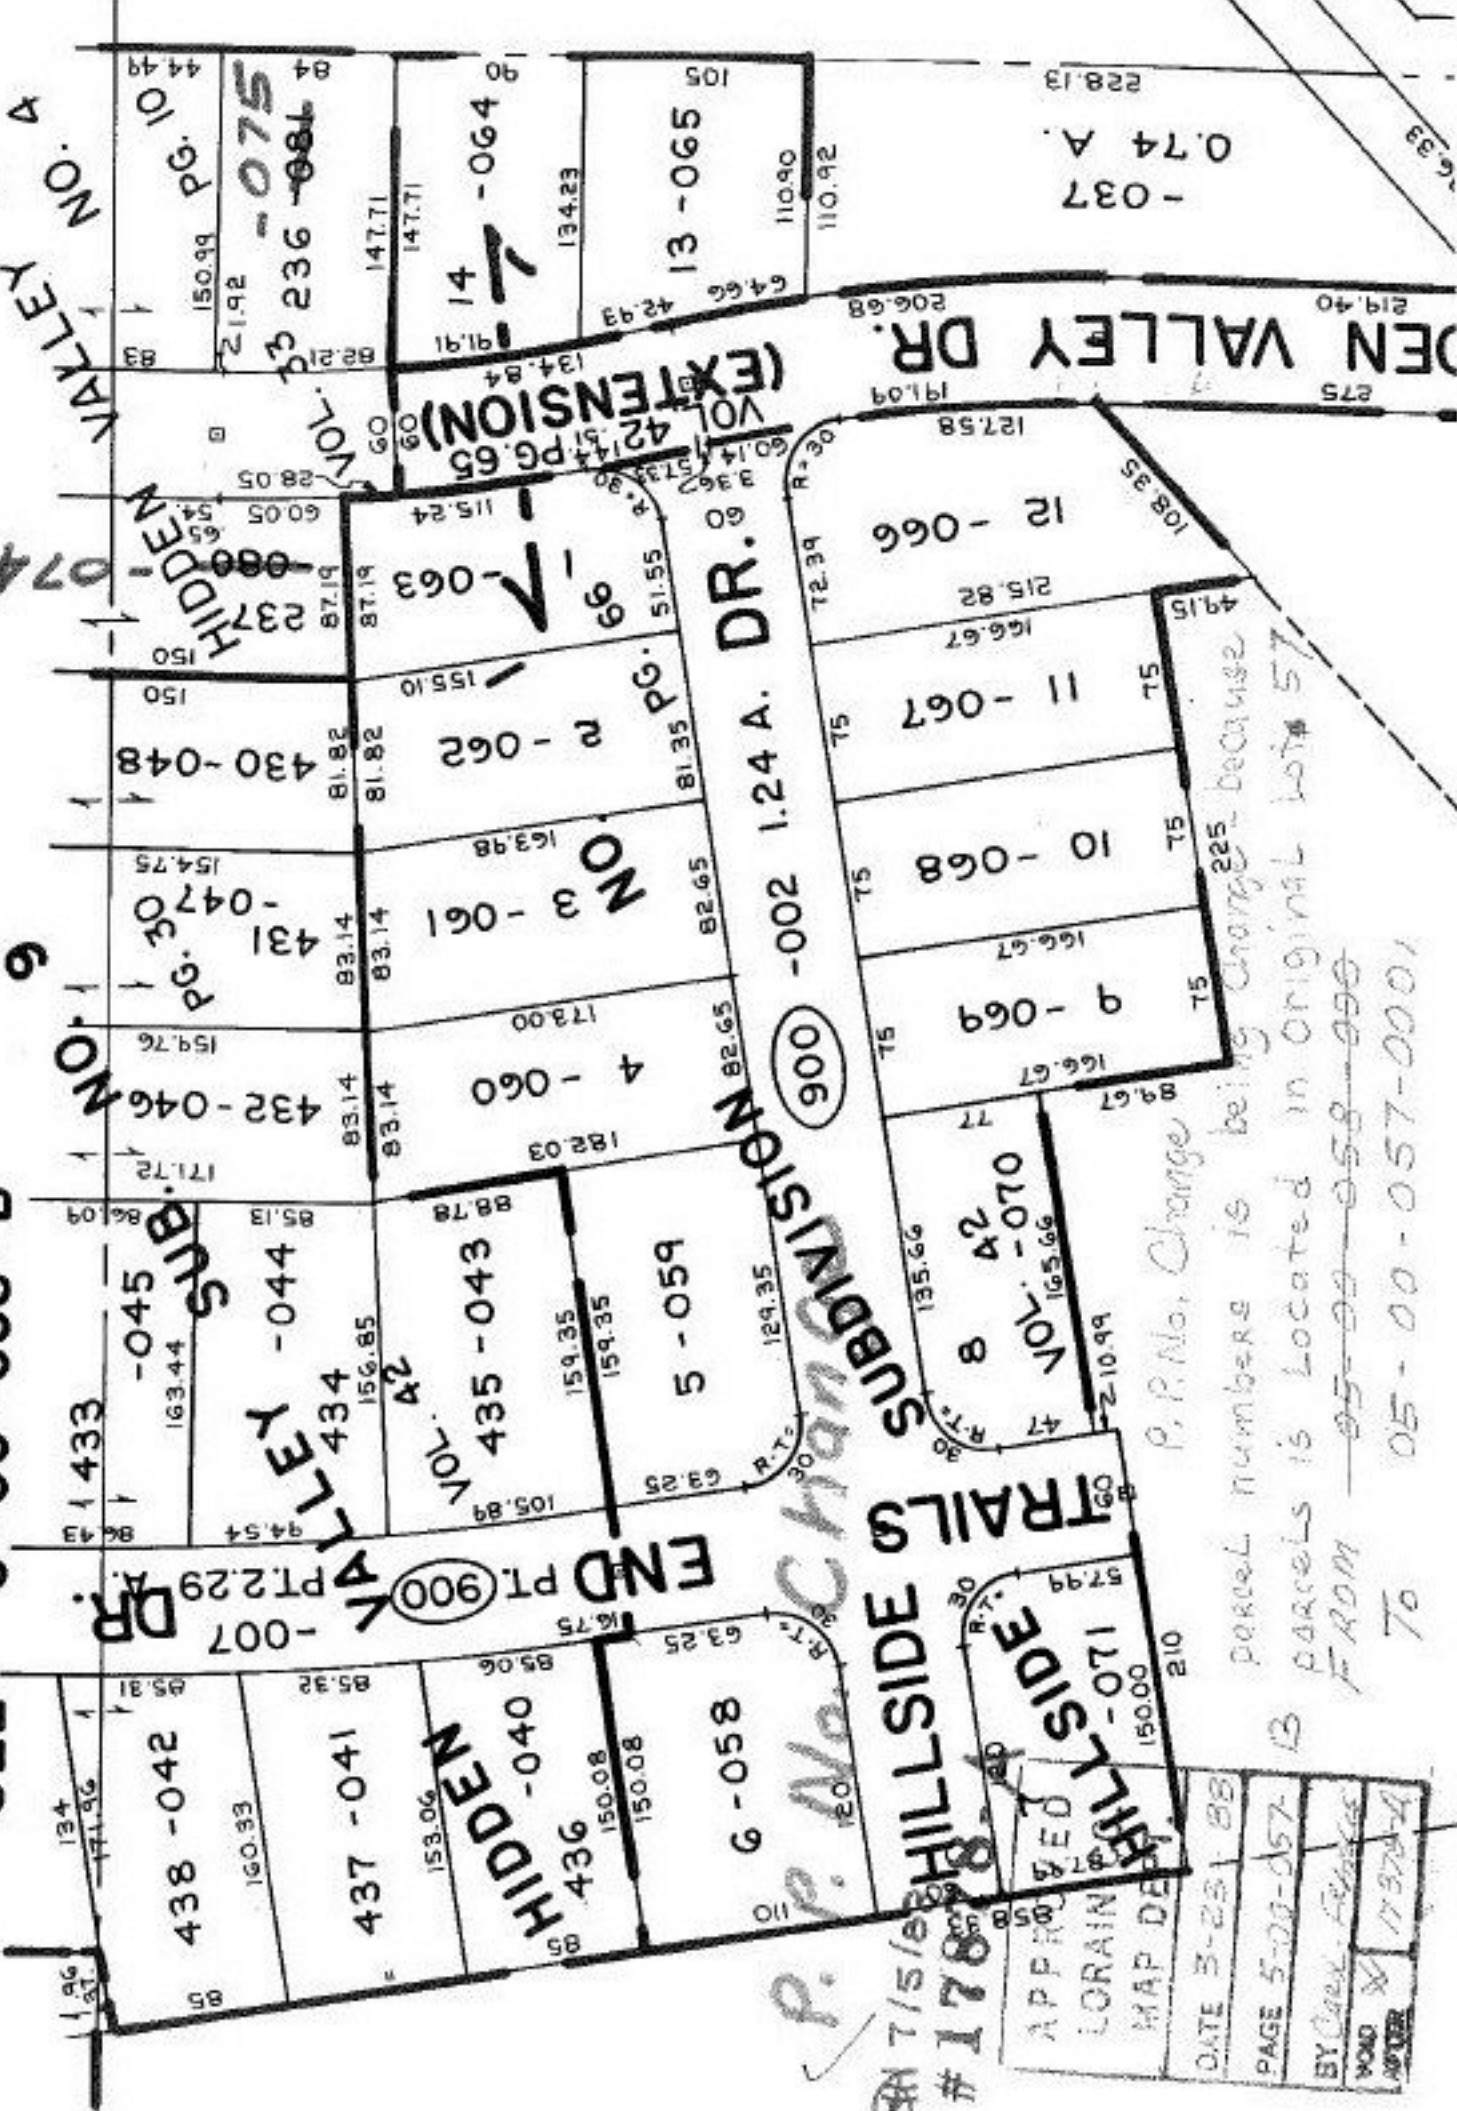

END PT. (900) DR. A. PT. 2.29

SUB. VALLEY

NO. 6

HIDDEN

NO. 4 SUB.

VALLEY

NO. 6

HIDDEN

NO. 4 SUB.

VALLEY

NO. 6

HIDDEN

NO. 4 SUB.

TRAILS HILLSIDE

P.P. No. Chan SUBMISSION (900)

DR. A. 1.24 A. -002

(EXTENSION) VOL. 42, 44 PG. 65

VALLEY NO. 4 SUB.

NO. 6

HIDDEN

NO. 4 SUB.

NO. 6

HIDDEN

NO. 4 SUB.

NO. 6

HIDDEN

NO. 4 SUB.

P.P. No. Change parcel numbers is being changed because parcels is located in original lot # 57 FROM 05-00-058-000 TO 05-00-057-0001

APPROVED
LORAIN
MAP DEPT.

DATE 3-23-88
PAGE 5-00-057
BY Gary S. Black
VOID AFTER 17378-A

SA 7/5/88 #17888