


WAKEMAN LAGRANGE RICHFIELD

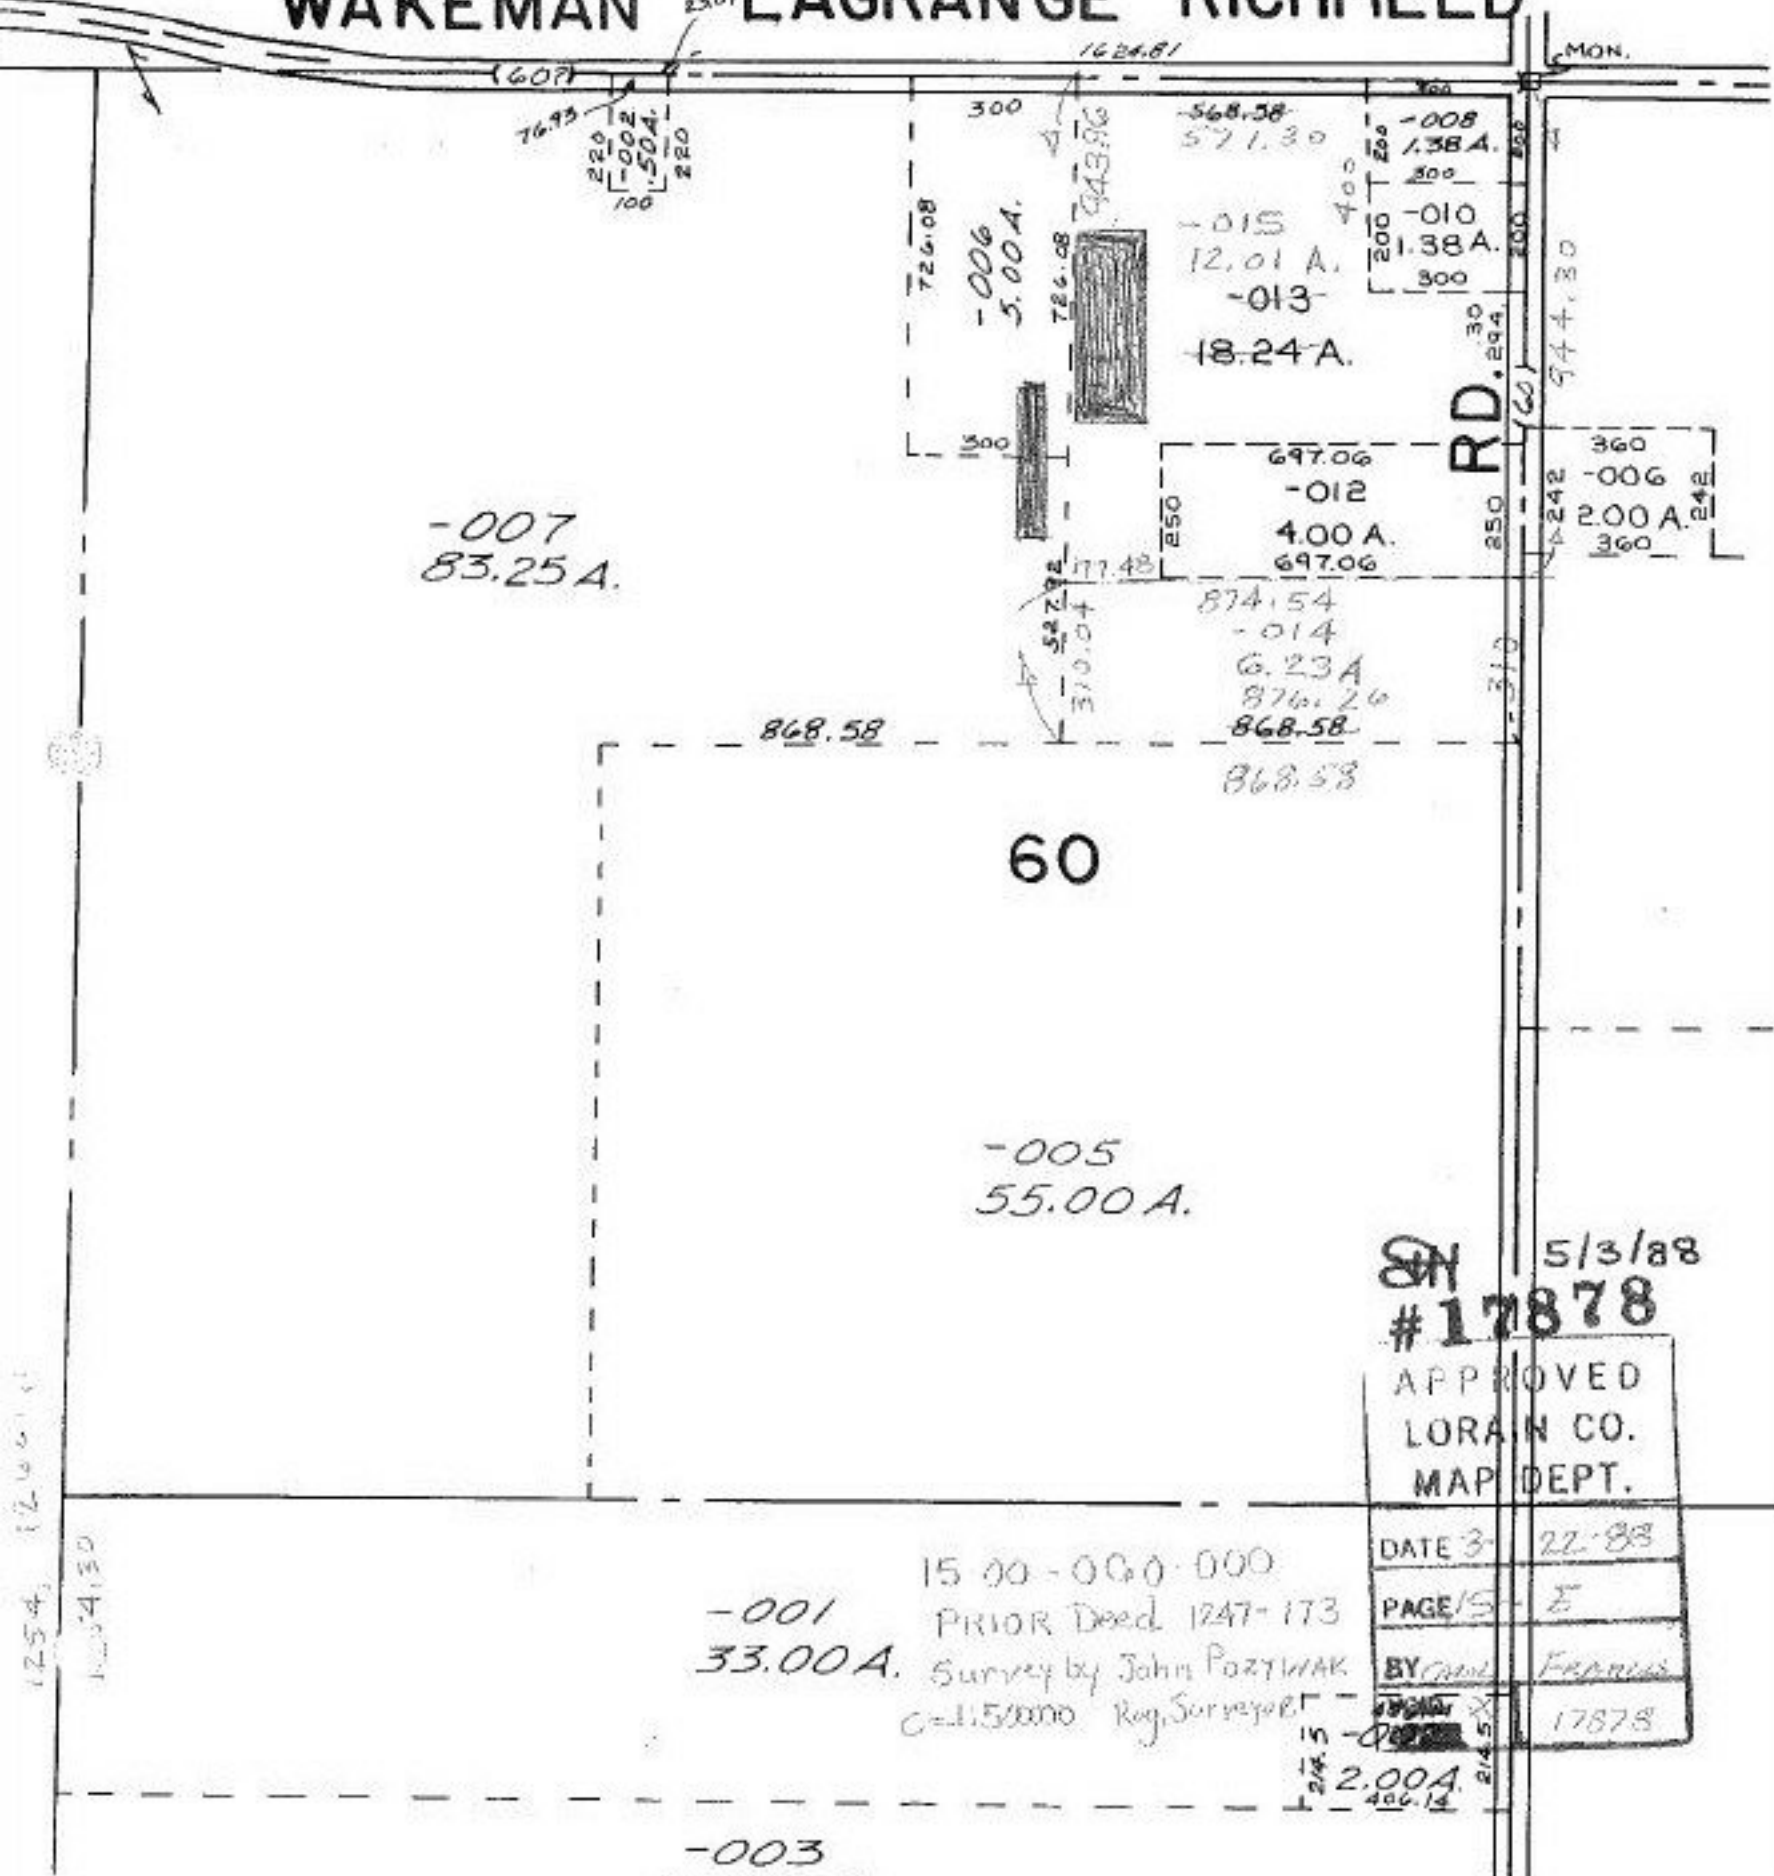

SN 5/3/88
#17878

APPROVED LORAIN CO. MAP DEPT.	
DATE	3-22-88
PAGE	15-E
BY	FRANZ
	17878

15 00 - 000 - 000
-001 PRIOR Deed 1247-173
33.00 A. Survey by John Poznyak
C=1150000 Reg. Surveyor

2.00 A.
406.14