


SEE 9-F

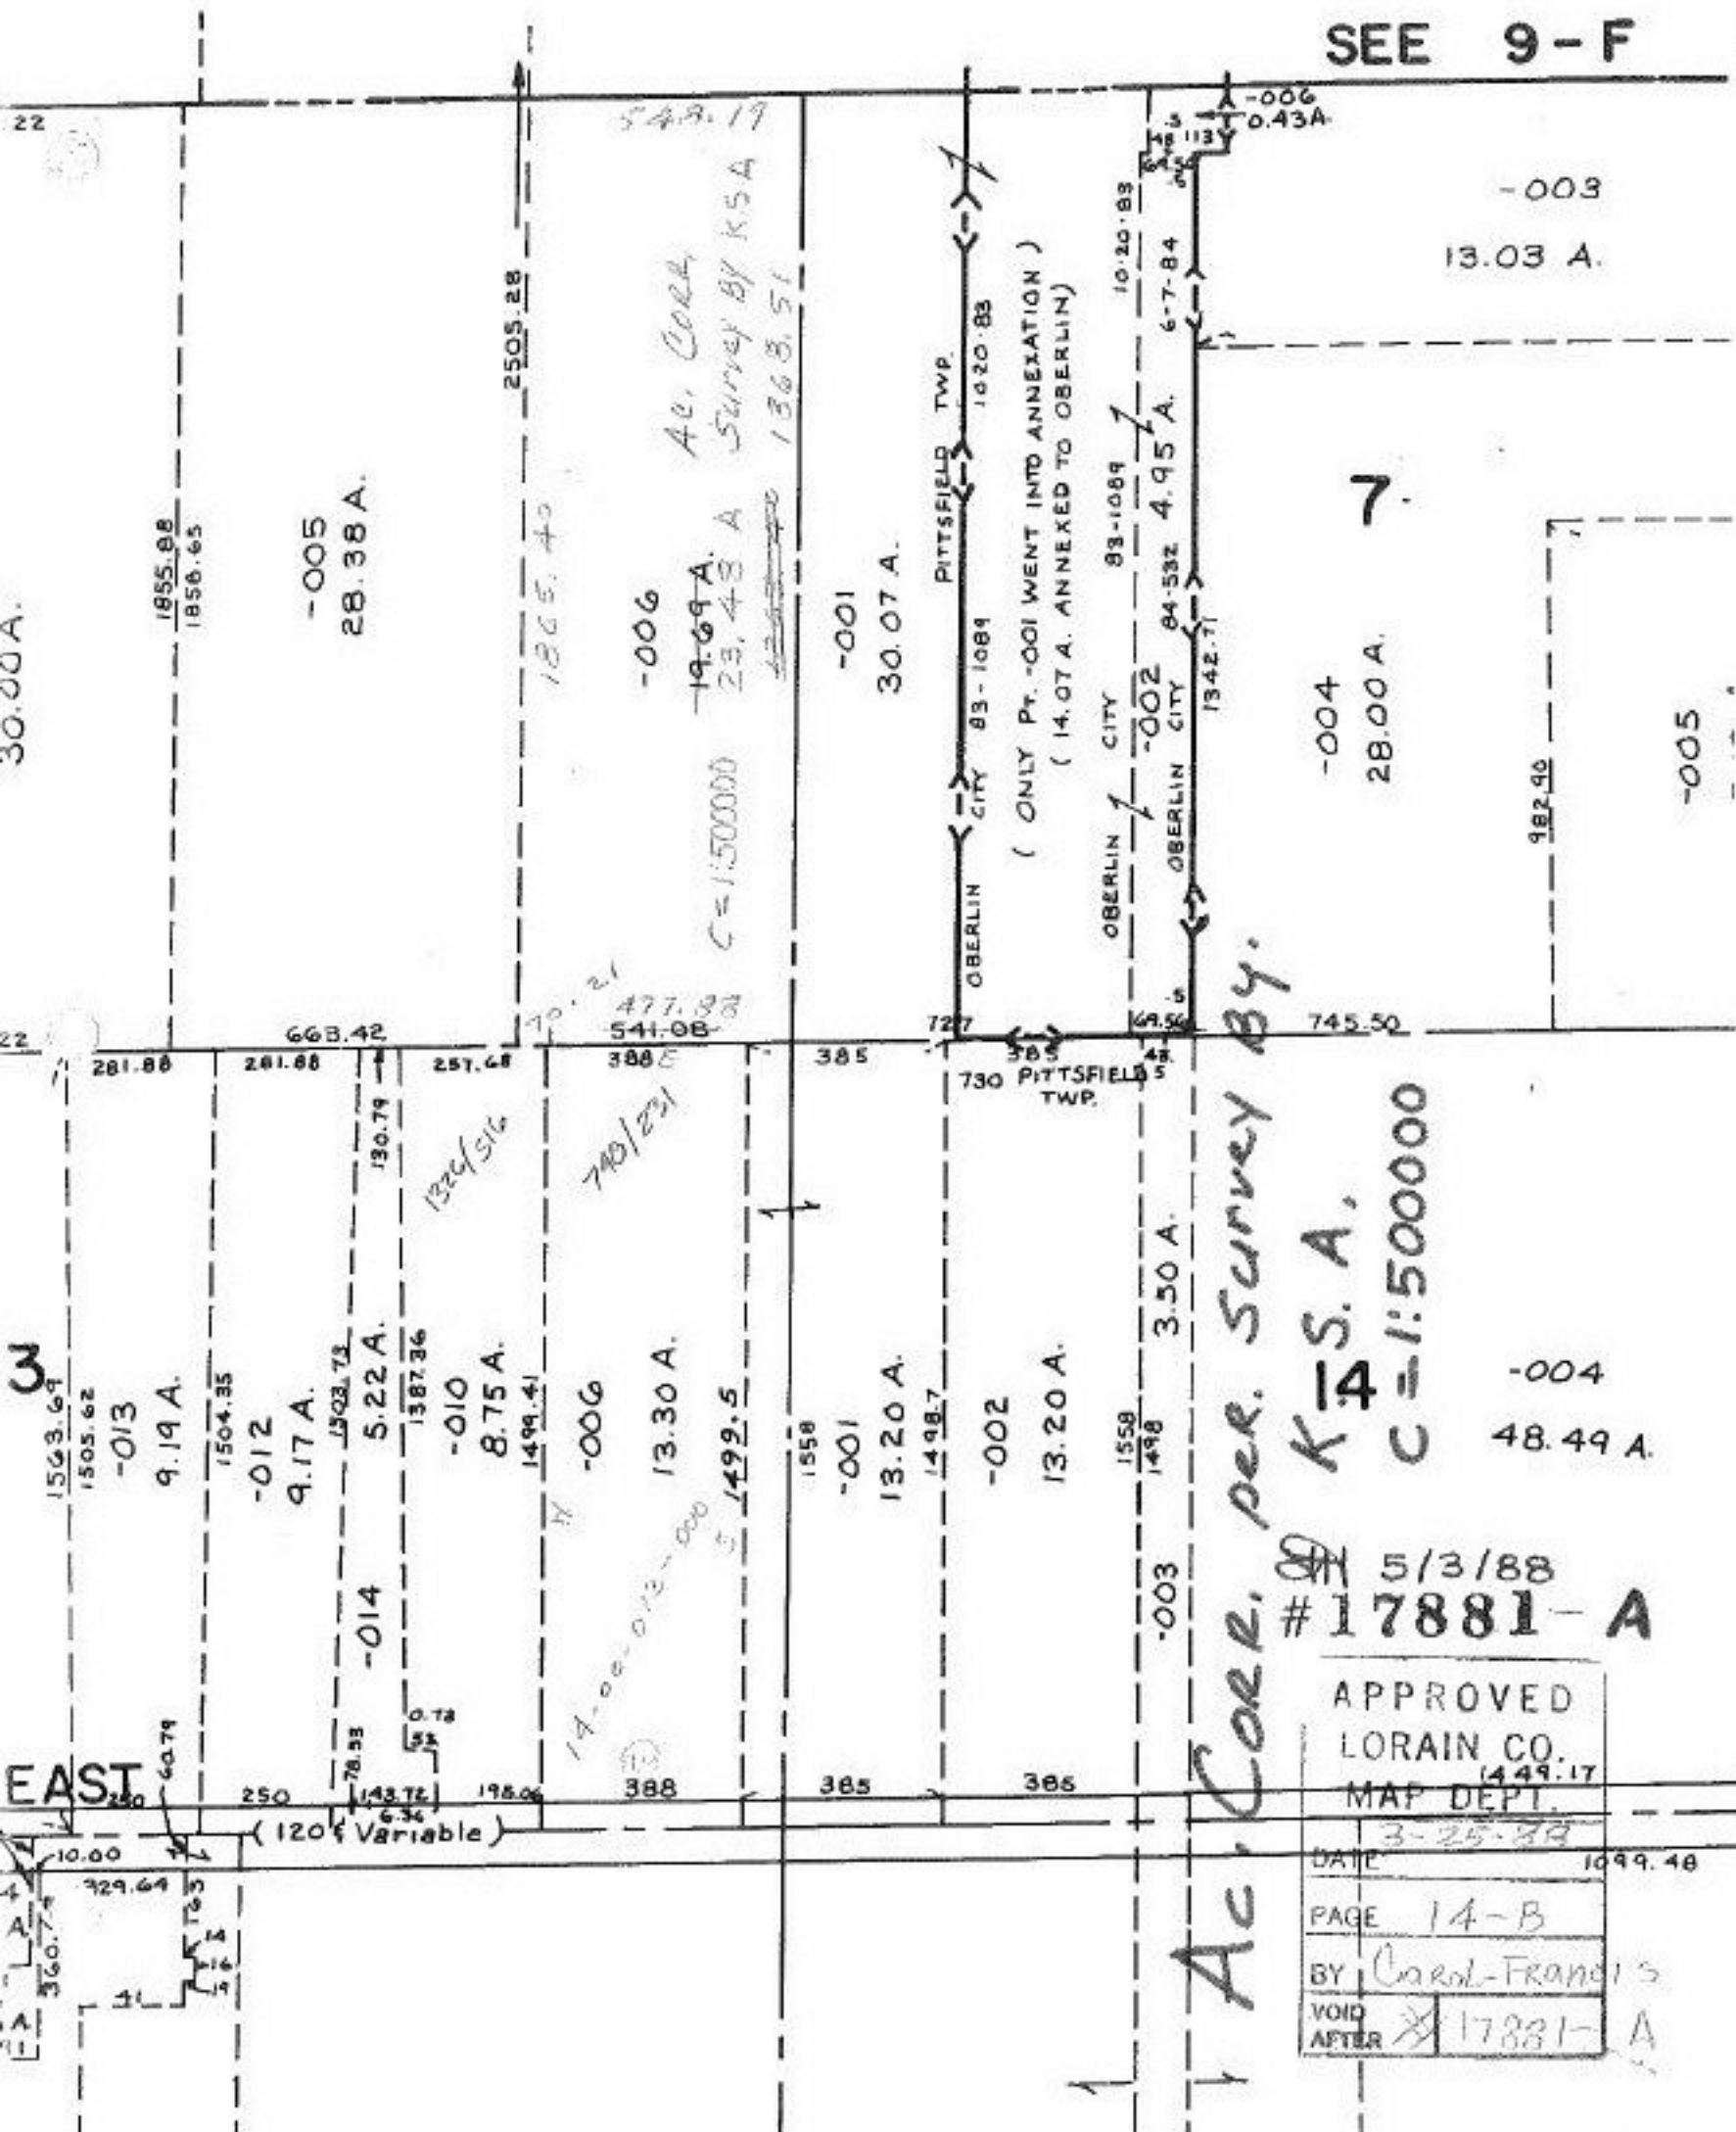

548.17

Ac. Corr. Survey By KSA

-006
19.69 A.
23.48 A
1368.51

70.21
477.9
541.08

-006
13.30 A.
1499.5

14.00-0.12-0.00
1499.5

-001
30.07 A.

PITTSFIELD TWP.
10.20.83
OBERLIN CITY 83-1089
OBERLIN CITY 84-532 4.95 A.
10.20.83
6-7-84
1342.71

727
385
730 PITTSFIELD TWP.

-002
13.20 A.
1498.7

-003
3.50 A.

-003
13.03 A.

-004
28.00 A.

-004
48.49 A.

-005

Ac. Corr. per. Survey By K.S.A.

C=1:500000

5/3/88
#17881-A

APPROVED
LORAIN CO.
MAP DEPT.
DATE 3-25-88
PAGE 14-B
BY Carol-Francois
VOID AFTER 17881-A

(120' Variable)

EAST