


SEE 1-00-003-A

SEE DETAIL

(LIBERTY AVE.)

RD. RD.

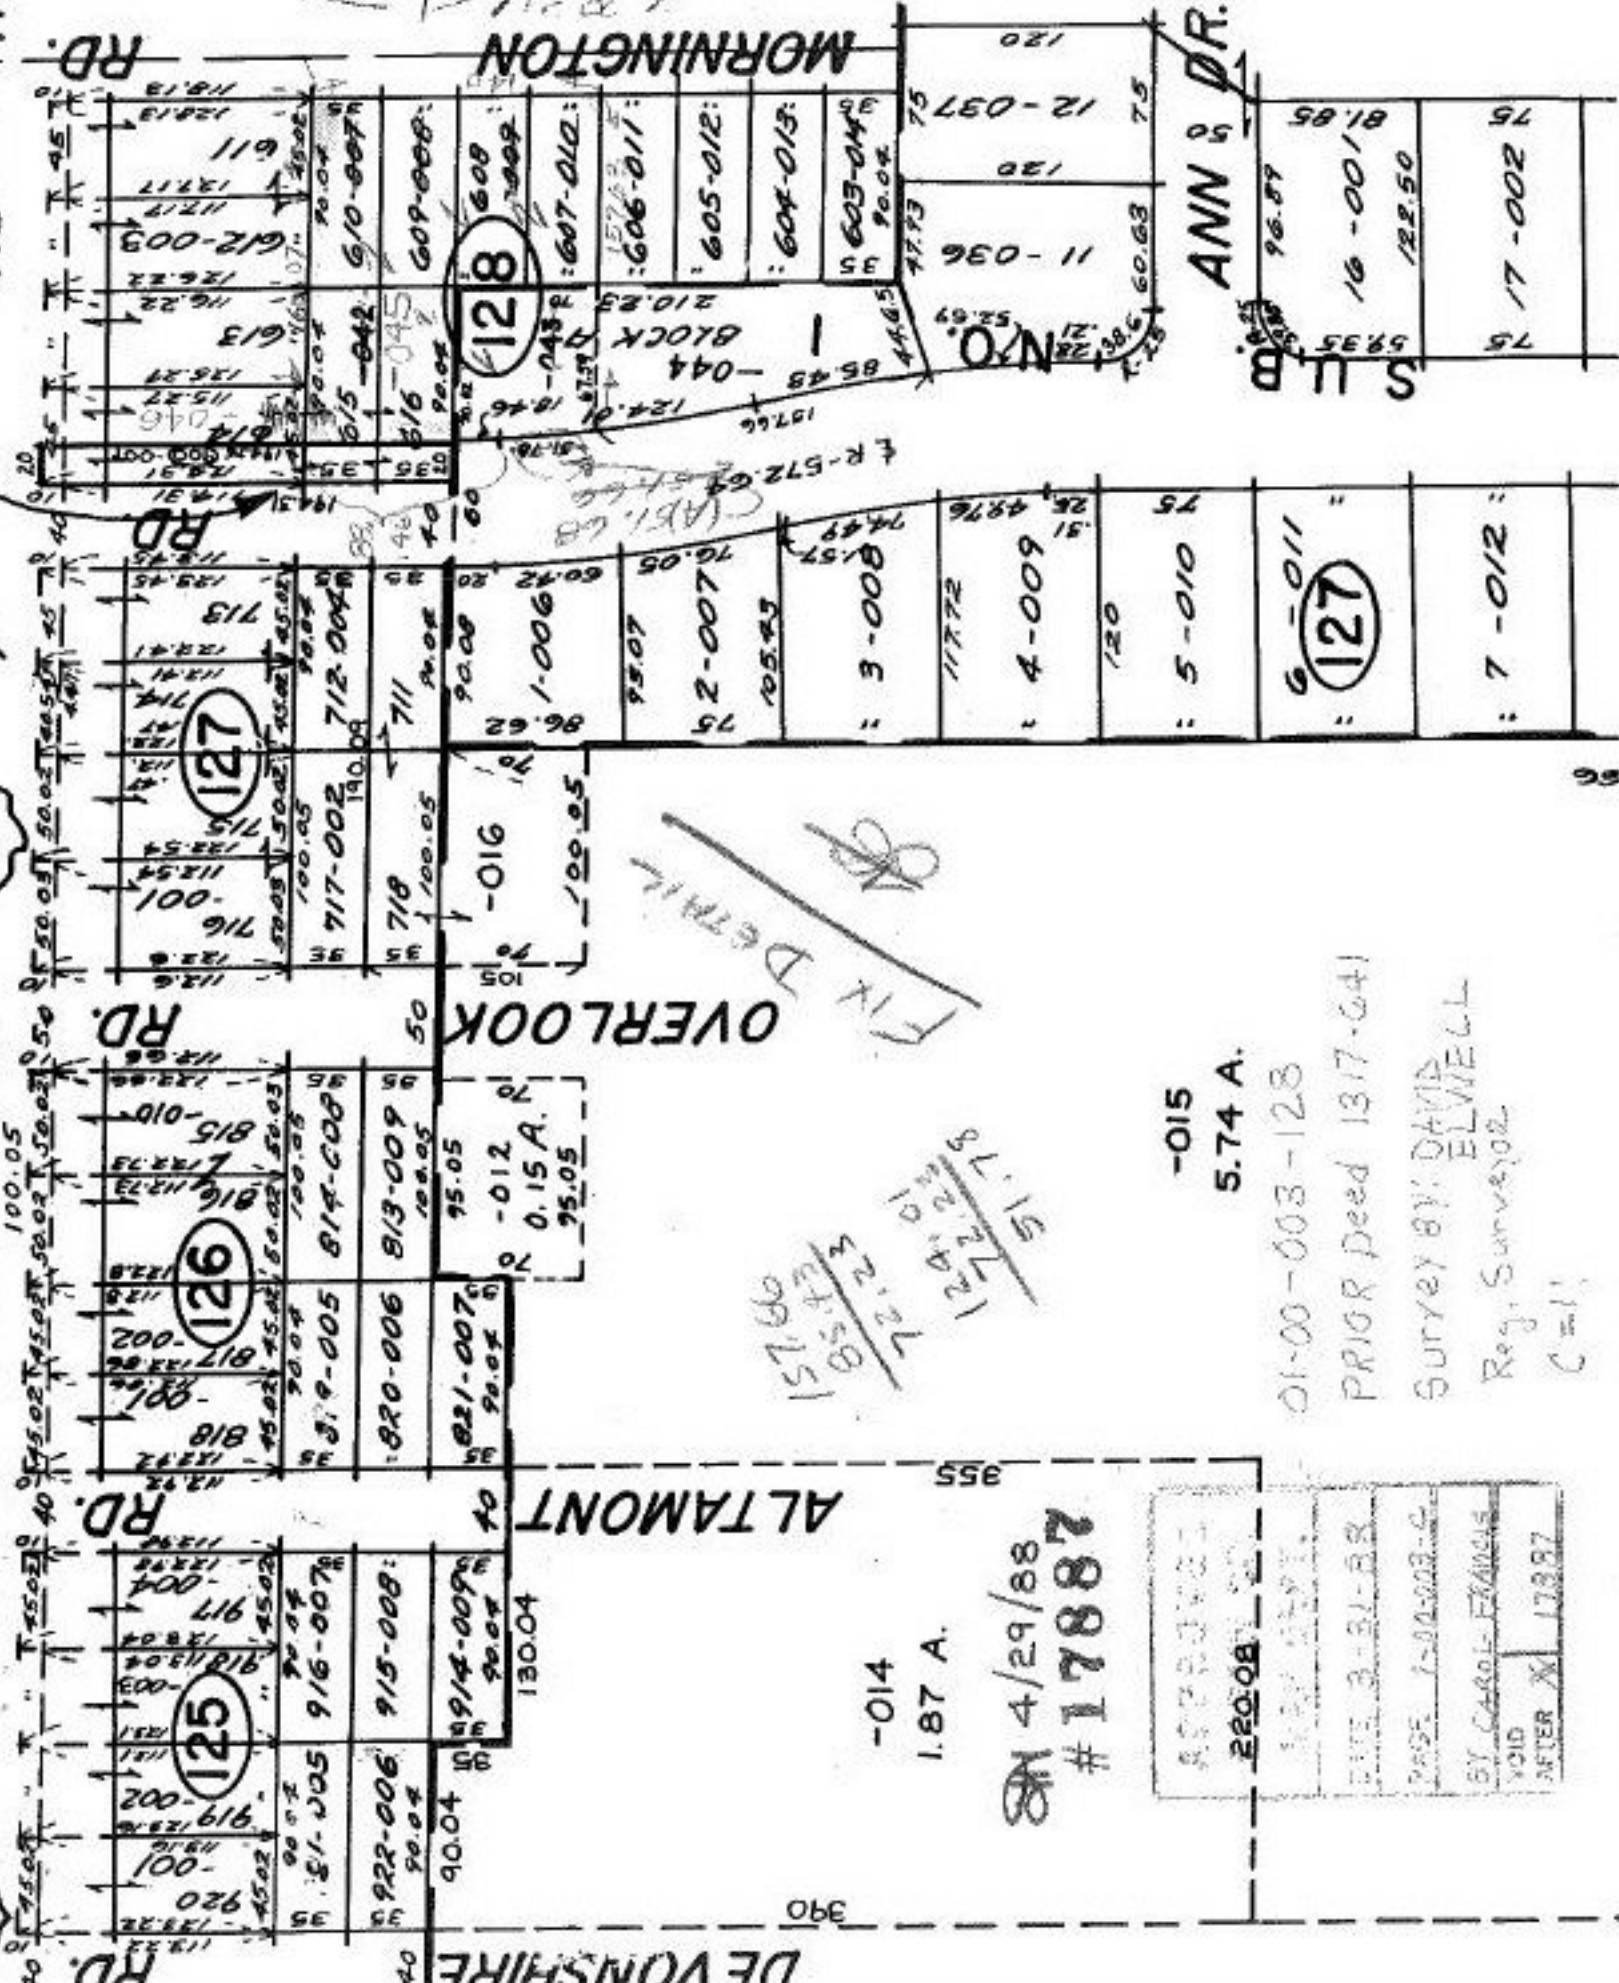

APPROVED  
 220.08  
 DATE 3-31-88  
 PAGE 1-00002-C  
 BY CAROL-FRANCIS  
 VOID AFTER X 17887