

07-00-031-000-

SHOW BOTH PARCELS (RED &

GREEN WHEN PUTTING SPLIT

ON MAP. -02A PARCEL

WILL HAVE TO BE REDRAWN

TO THE R/W LINE OF

STONEY RIDGE INSTEAD

OF THE CL. SURVEY

DOES NOT AGREE

WITH DEERS FOR

-02A SO SHOW

S89-06-59E 3171.22

BOTH SETS OF

LINE & DIMENSIONS.

THIS PROBLEM DISCUSSED

WITH DAVE BULLWELL (K.S. ASSOC)

& DONADA STASKEWIS (GREAT LAKE

TITLE) BEFORE SPLIT WAS

COMPLETED ON 4-15-88

#17889


SEE FRANK ABOUT

DIFFERENT INTERP-

RETATIONS OF

DEERS, ETC..

APPROVED	
LORAIN CO.	
MAP DEPT.	
DATE	4-18-88
PAGE	7-13
BY	T. M. Main
VOID AFTER	17889

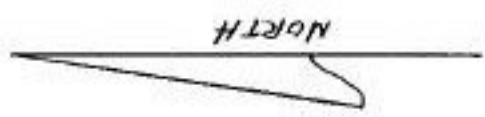

STONEY

S 546.03
S 39-17-30 E

N 54-13-52 E 160.69
N 52-20 E
S 38-50-30 W 130.50

S 52-38-30 W
S. 56'

N 37-10 W
51.21'

-02A
-05.0

O.L. 31

O.L. 32

N 37-30 W 132'

RIDGE

ORIGINAL CENTERLINE

RD.

DETAIL DRAWING

SCALE 1" = 50'

BLACK = ROAD R/W, OL LINE

GREEN = DV 1297/394, 914/224, 273/392

RED = K.S. SURVEY