


1788  
1789

Peck  
Wadsworth Rd

(LAGRANGE RD.)

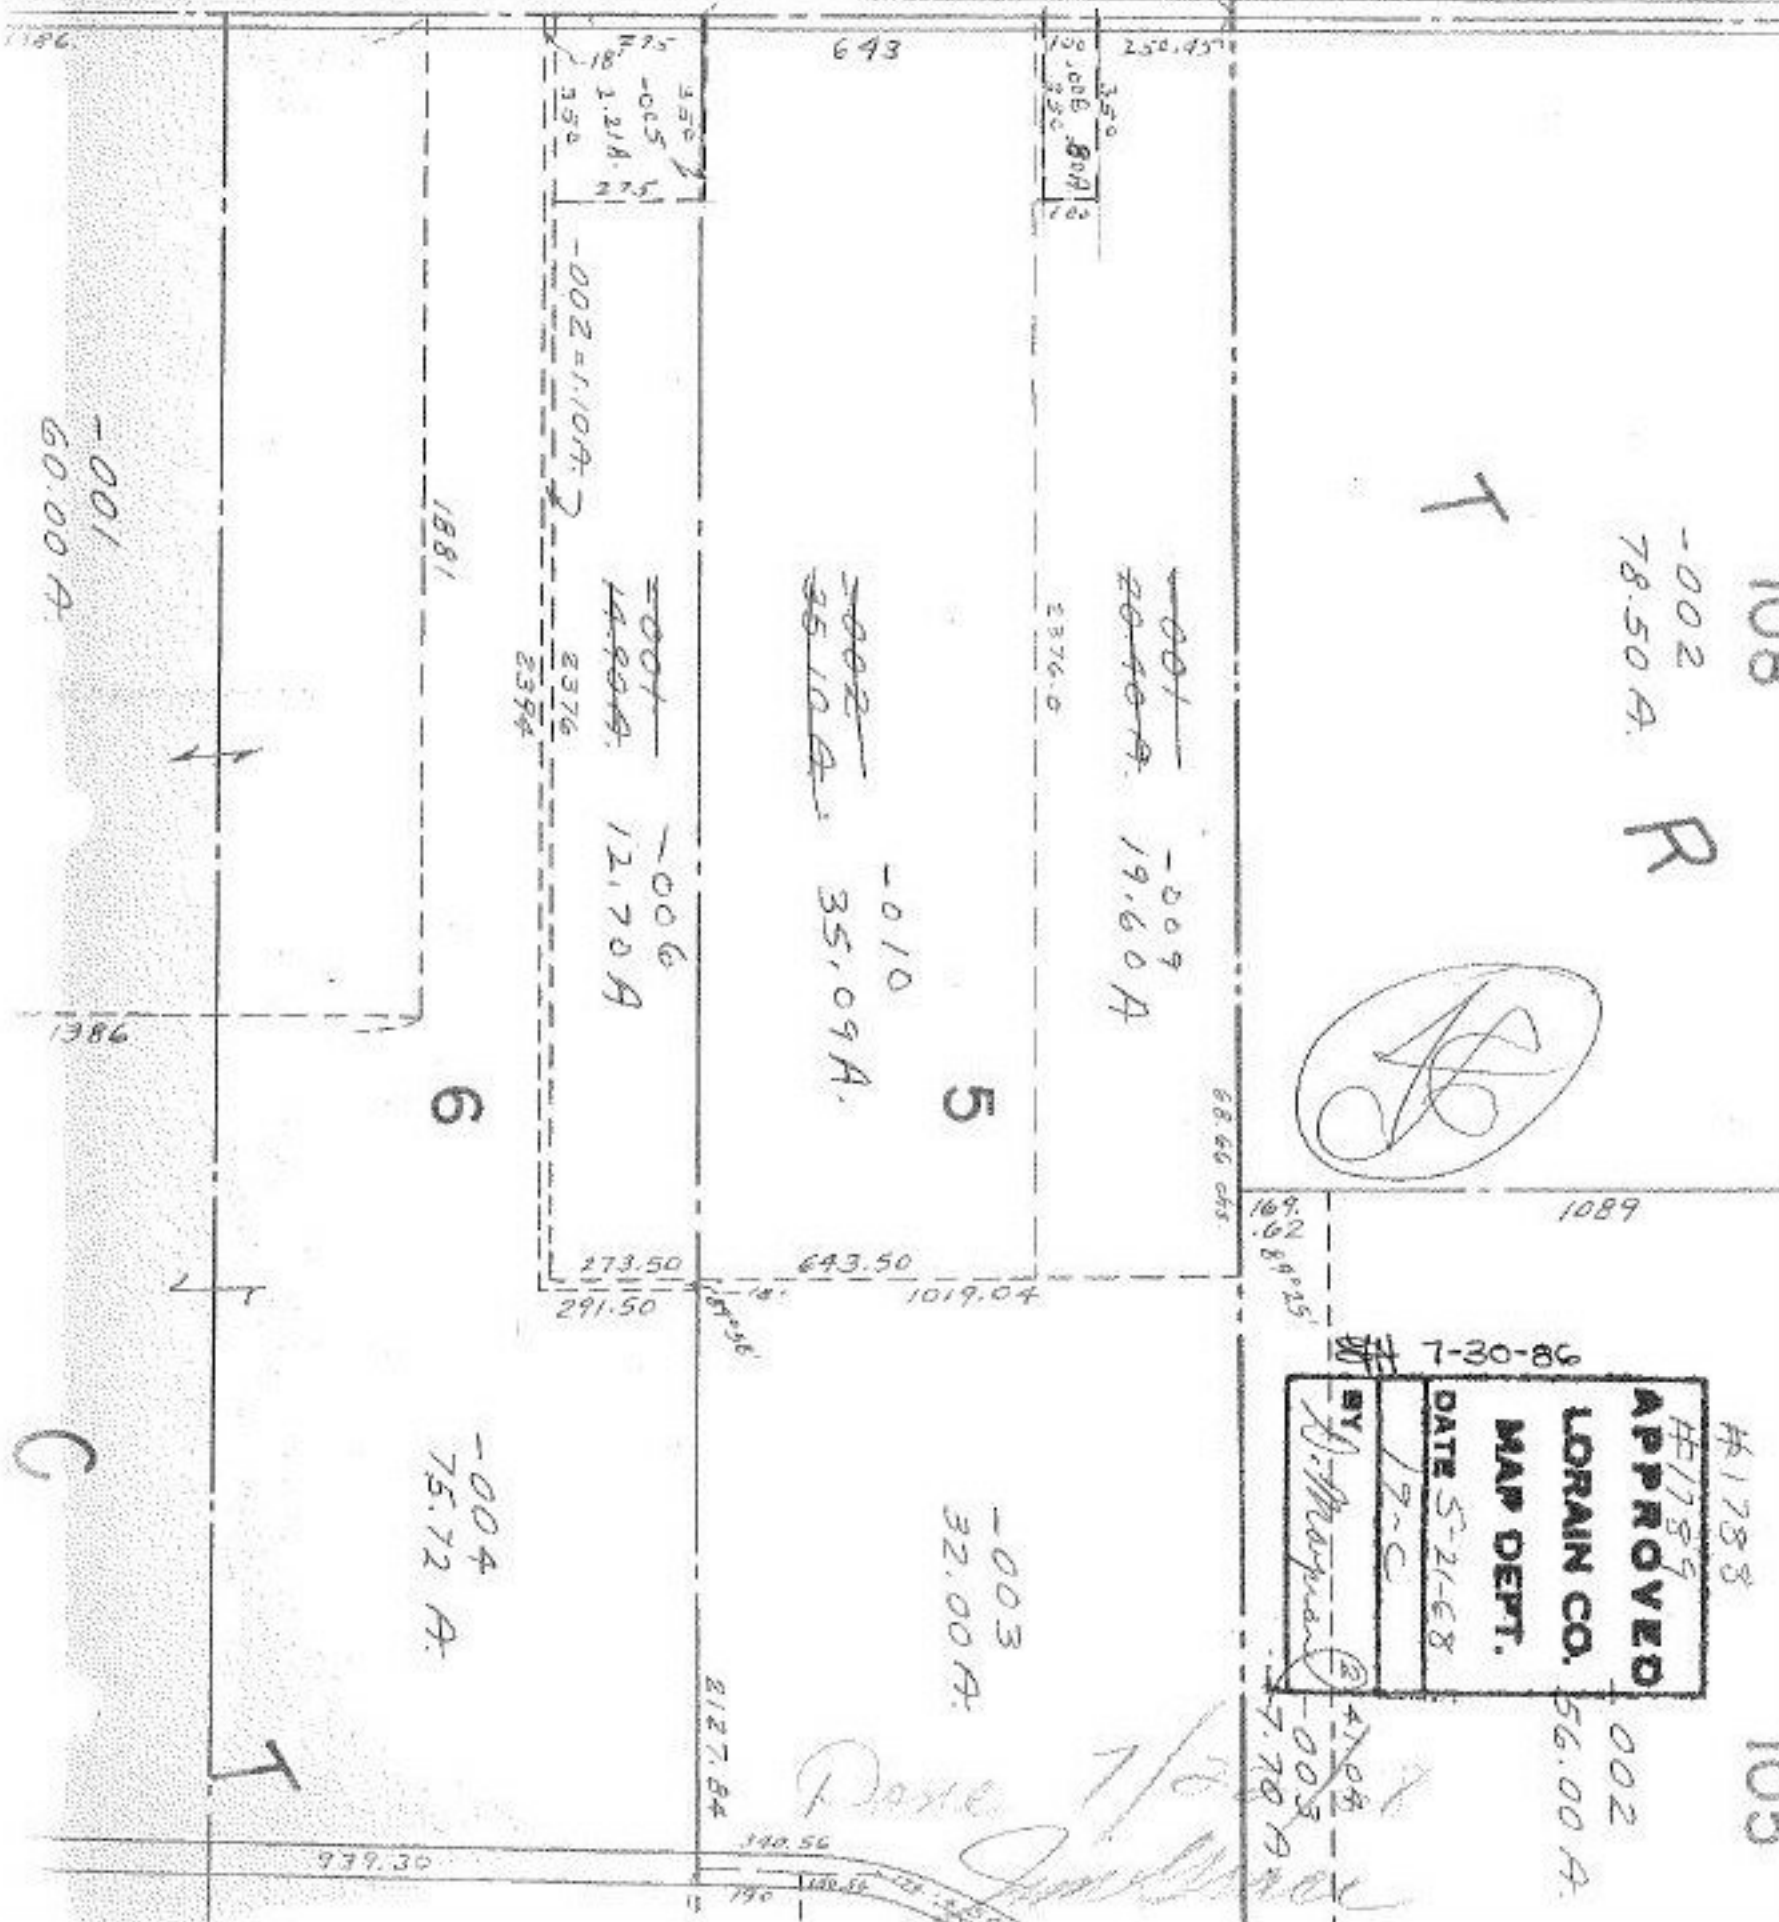

108

-002  
78.50 A.

R

*(Signature)*

1089

#1788

7-30-86

BY	A. Morrison
DATE	5-21-68
DATE	7-30-86

APPROVED  
LORAIN CO.  
MAP DEPT.

105

002  
56.00 A.

Done 7/20/86  
*(Signature)*

-001  
60.00 A.

-004  
75.72 A.

-003  
32.00 A.

-010  
35.09 A.

-006  
12.70 A.

-009  
19.60 A.

-002 = 1.10 A.

~~002~~  
35.10 A.

~~001~~  
14.99 A.

1881

2376.0

643

250.45

993.45

1186

981

6

5

68.66 chs

273.50  
291.50

643.50  
1019.04

169.29  
89.25

2127.84

340.56

939.30

C

T

T