


- 091
 - 050
 6.13 A.
 6.67A

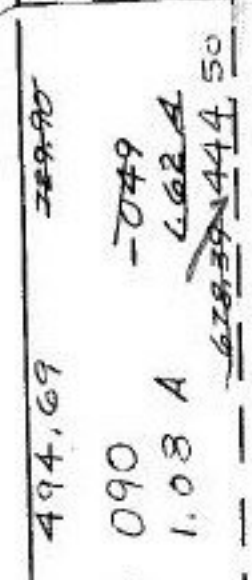

4/25/88
 #17896-A

CHESTNUT
COMBINATION

APPROVED
 RIDGE
 PLAIN CO.
 MAP DEPT.
 DATE 4-7-88
 PAGE 11-00-070-A
 BY CAROL FRANCIS
 VOID * 17896-A
 AFTER

#17893

11-00-070-
 PRIOR
 Deed
 Survey By
 K.E. McCarty's
 Assoc.
 C-1: 62500

* 17893

MAP DEPT.
 DATE 4-6-88
 PAGE 11-00-070-A
 BY CAROL FRANCIS
 VOID * 17893
 AFTER