


10-00-006-H

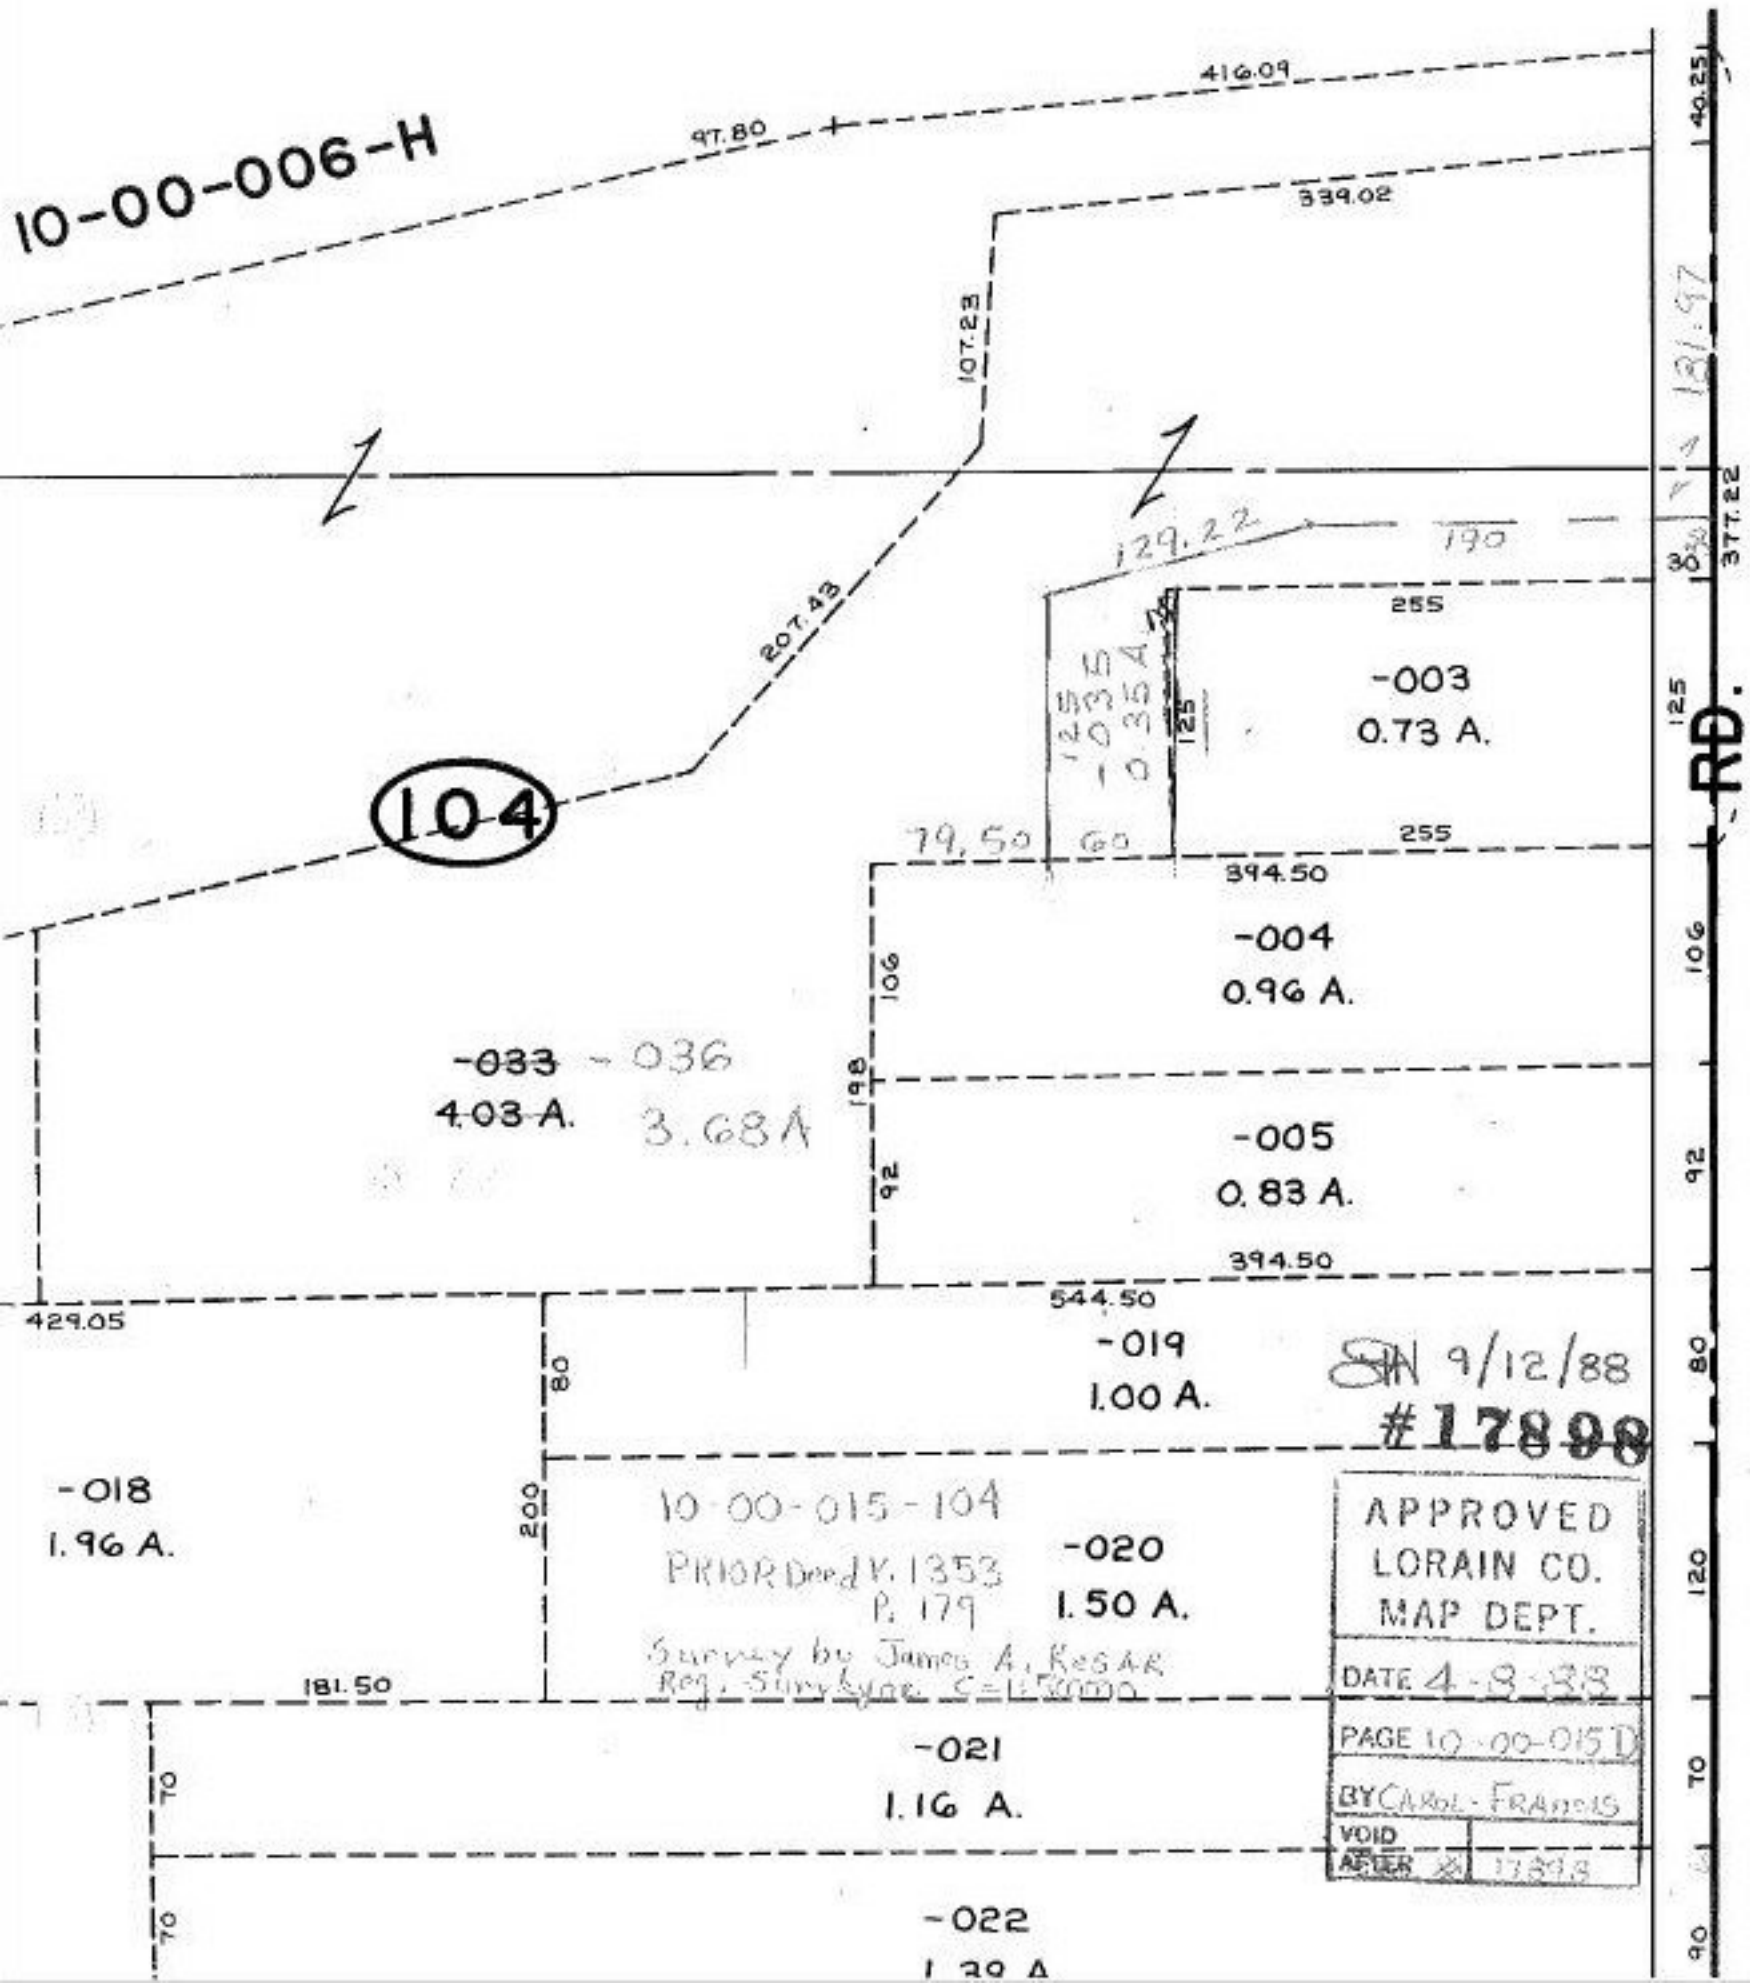

104

-033 - 036  
4.03 A. 3.68 A.

125  
-035  
0.35 A.

-003  
0.73 A.

-004  
0.96 A.

-005  
0.83 A.

-019  
1.00 A.

-018  
1.96 A.

10-00-015-104

PRIOR Deed V. 1353  
P. 179

Survey by James A. Resak  
Reg. Surveyor, C=113000

-020  
1.50 A.

-021  
1.16 A.

-022  
1.39 A.

SN 9/12/88  
#17898

APPROVED	
LORAIN CO.	
MAP DEPT.	
DATE 4-9-88	
PAGE 10-00-015 D	
BY CAROL FRANCIS	
VOID	
AFTER	17898

40.25  
131.97  
377.22  
RD.  
125  
106  
92  
80  
120  
90