
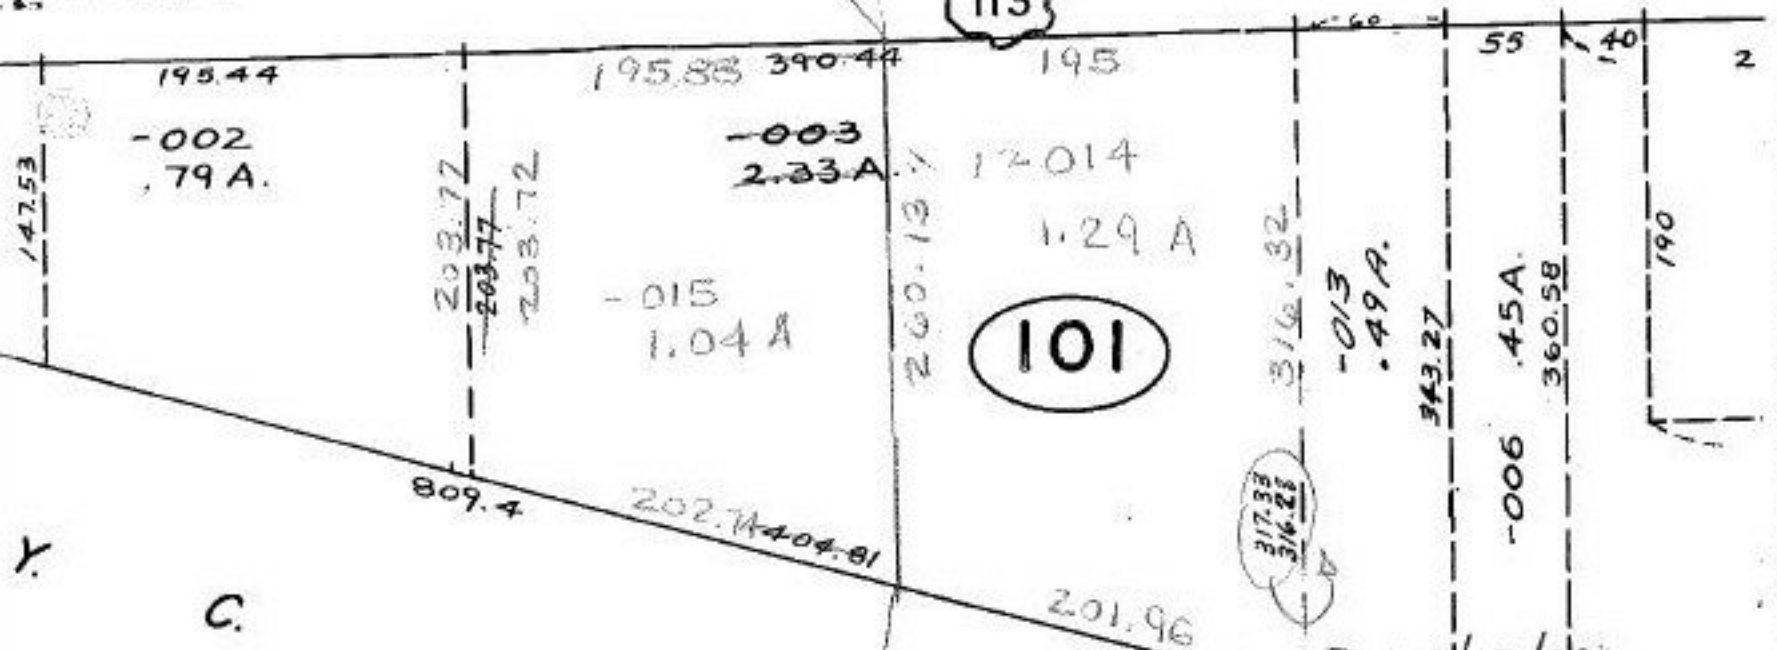


25

BLK. A

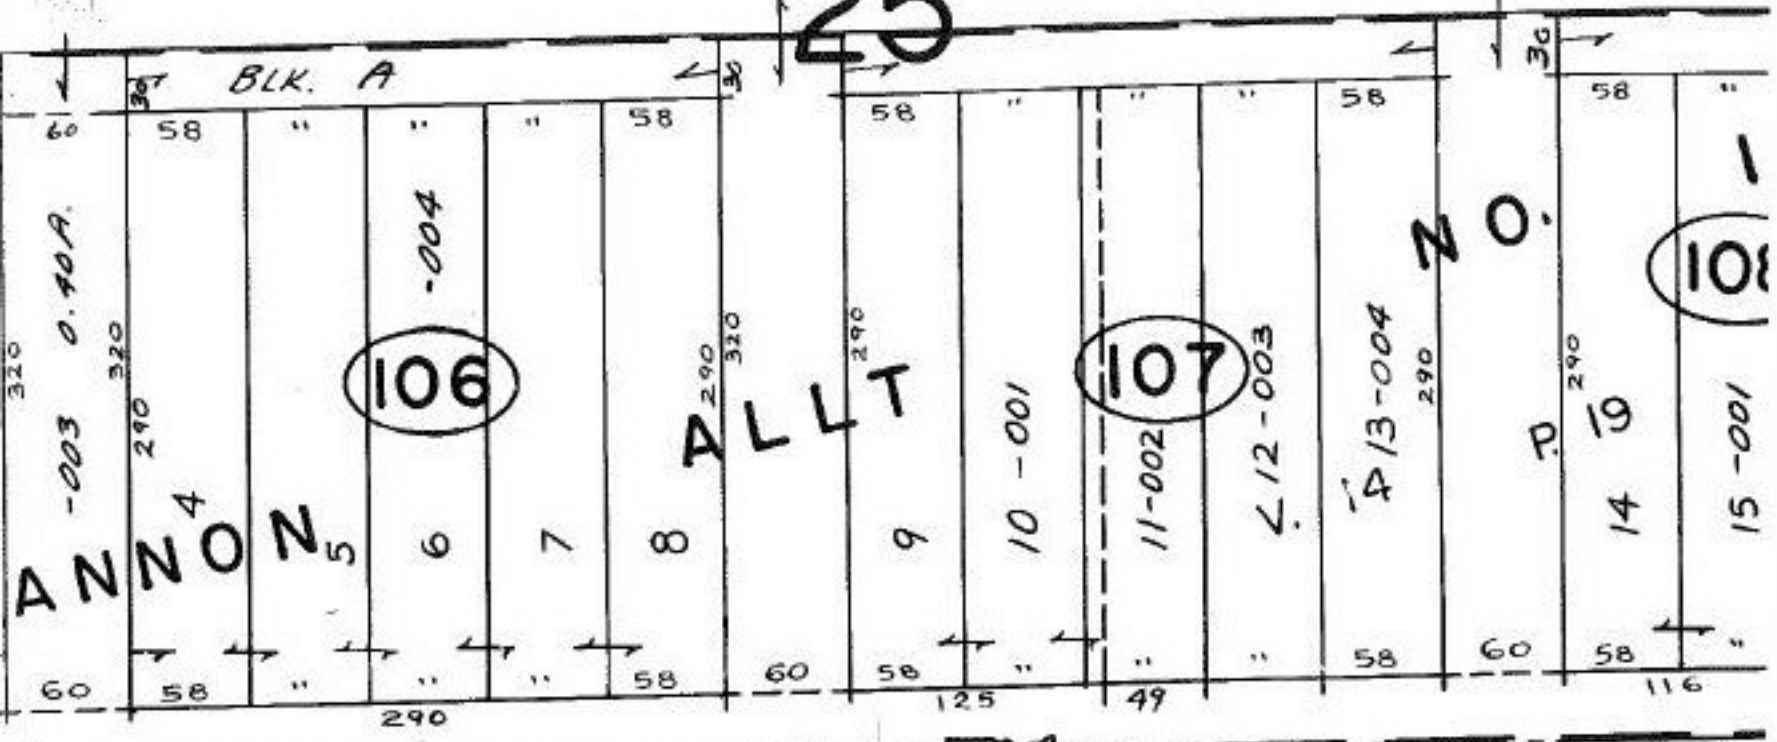

500

4/25/88  
#17902

APPROVED	
LORAIN CO.	
PL. SEPT.	
DATE	11 35 4-12-25
PAGE	6-96
BY	CAROL FRANKS
VOID #	17902
ATTN	

Pt. 06-24-012-101  
 Prior deed 821-24  
 Survey By:  
 Gary Penfound  
 Reg. Surveyor.  
 C-130, III.