

VACATION PER,
ORDINANCE No.
1024 & 1036

ORD. No. 1024
PASSED
MAR. 28, 1988

ORD. No. 1036
PASSED
MAY 9, 1988


104

VACATED
20.1730
AC.

BROOKSIDE ESTATES

BERKELEY ST.

ABBE

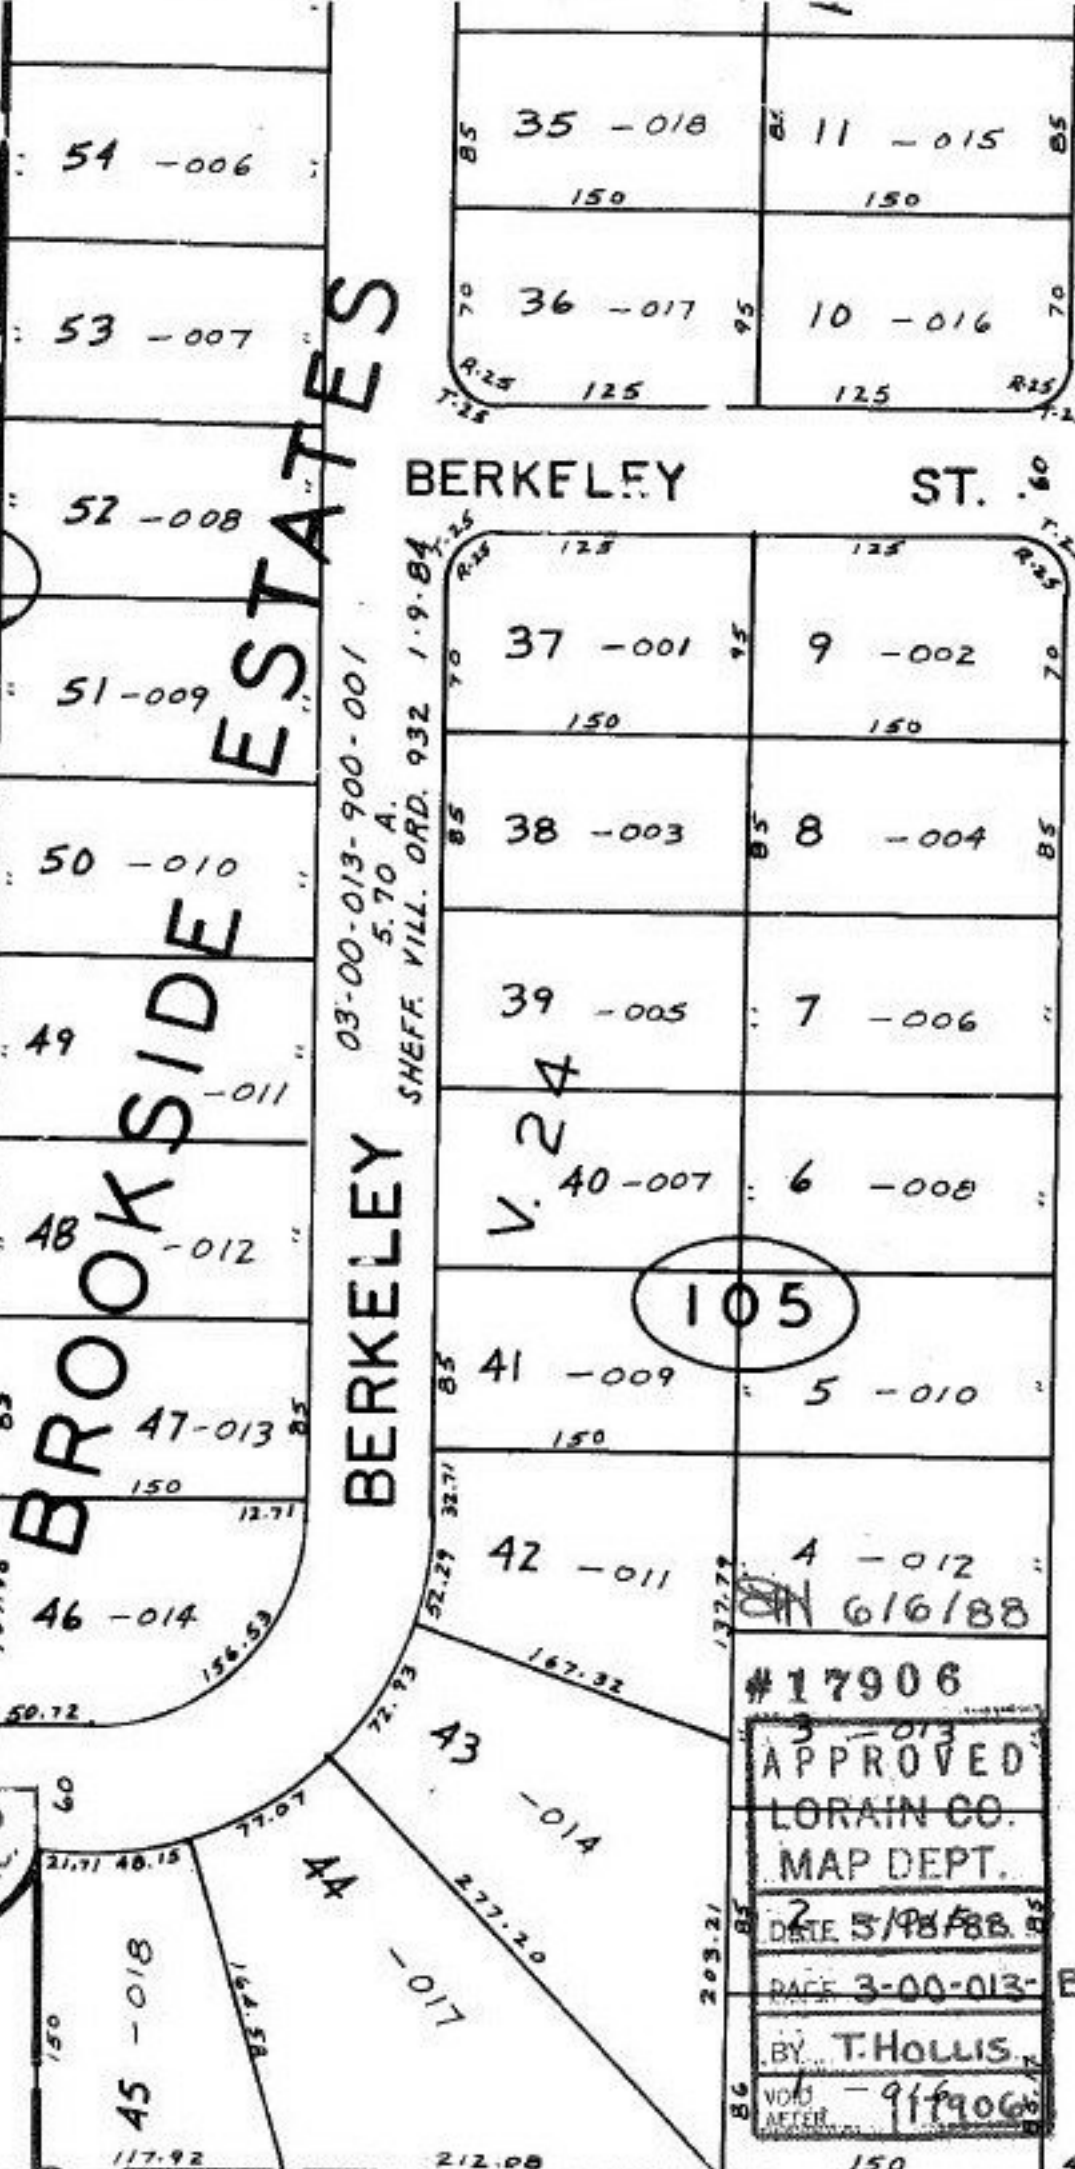

#17906
APPROVED
LORAIN CO.
MAP DEPT.
DATE 5/98/88
PAGE 3-00-013-B
BY T. HOLLIS
VOID AFTER 9119066