


-006
23.62 A.

-001
28.50 A.

#17912
P. 1 & 1912

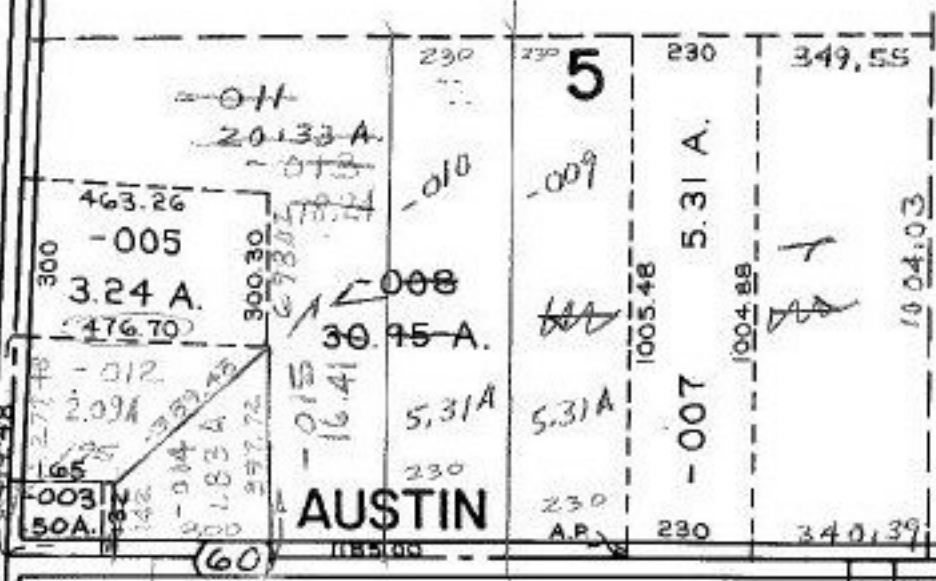


-004
15.60 A.

-001
30.00 A.

ASHLAND - KIPTON

#17913

14
-001
60.29 A.

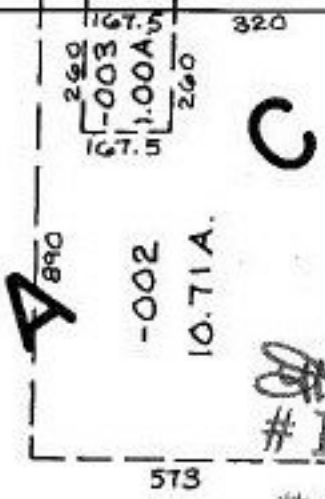

6/6/88
#17913
#17912

APPROVED
LORAIN CO.
MAP DEPT.
DATE 5-5-88
PAGE 13-G

13-08-005-000
PRIOR Deed 320/369
Survey By: M. HURA

BY Carol Francis
17912-13

DEN TWP TRACT 8 LOTS 5, 6
" 9 " 5, 6,

400'

511