


-006
23.62 A.

-001
28.50 A.

#17912
P. 1 & 11912

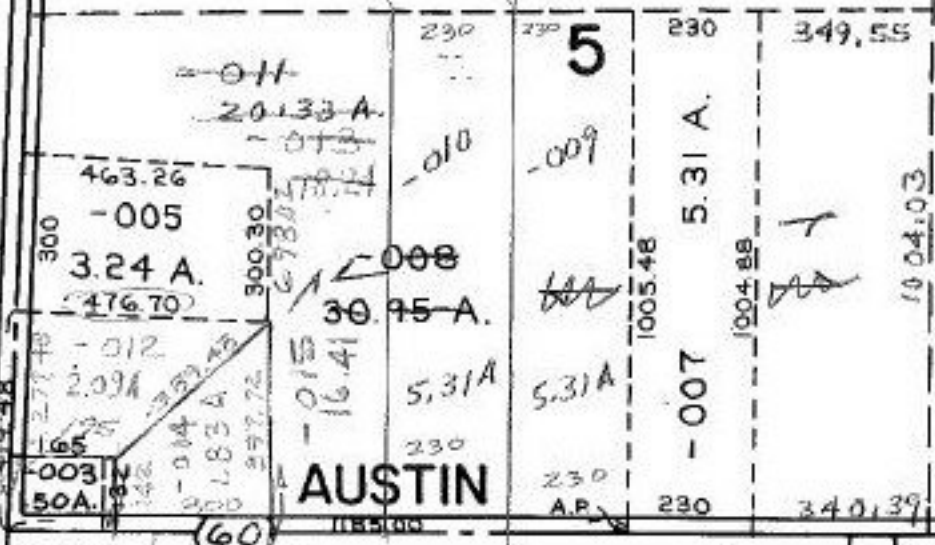


-004
15.60 A.

-001
30.00 A.

ASHLAND - KIPTON

#17913

14
-001
60.29 A.

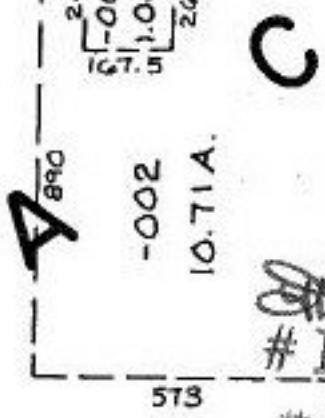

6/6/88
#17913
#17912

APPROVED	
LORAIN CO.	
MAP DEPT.	
DATE	5-5-88
PAGE	13-G
BY Carol Francis	
FILED AFTER	X 17912-13

13-08-005-000
PRIOR Deed 320/369
Survey BY: M. HURA

DEN TWP.

SEE 17-C
TRACT 8 LOTS 5, 6
" 9 " 5, 6,

400'