


ABBE

RD.

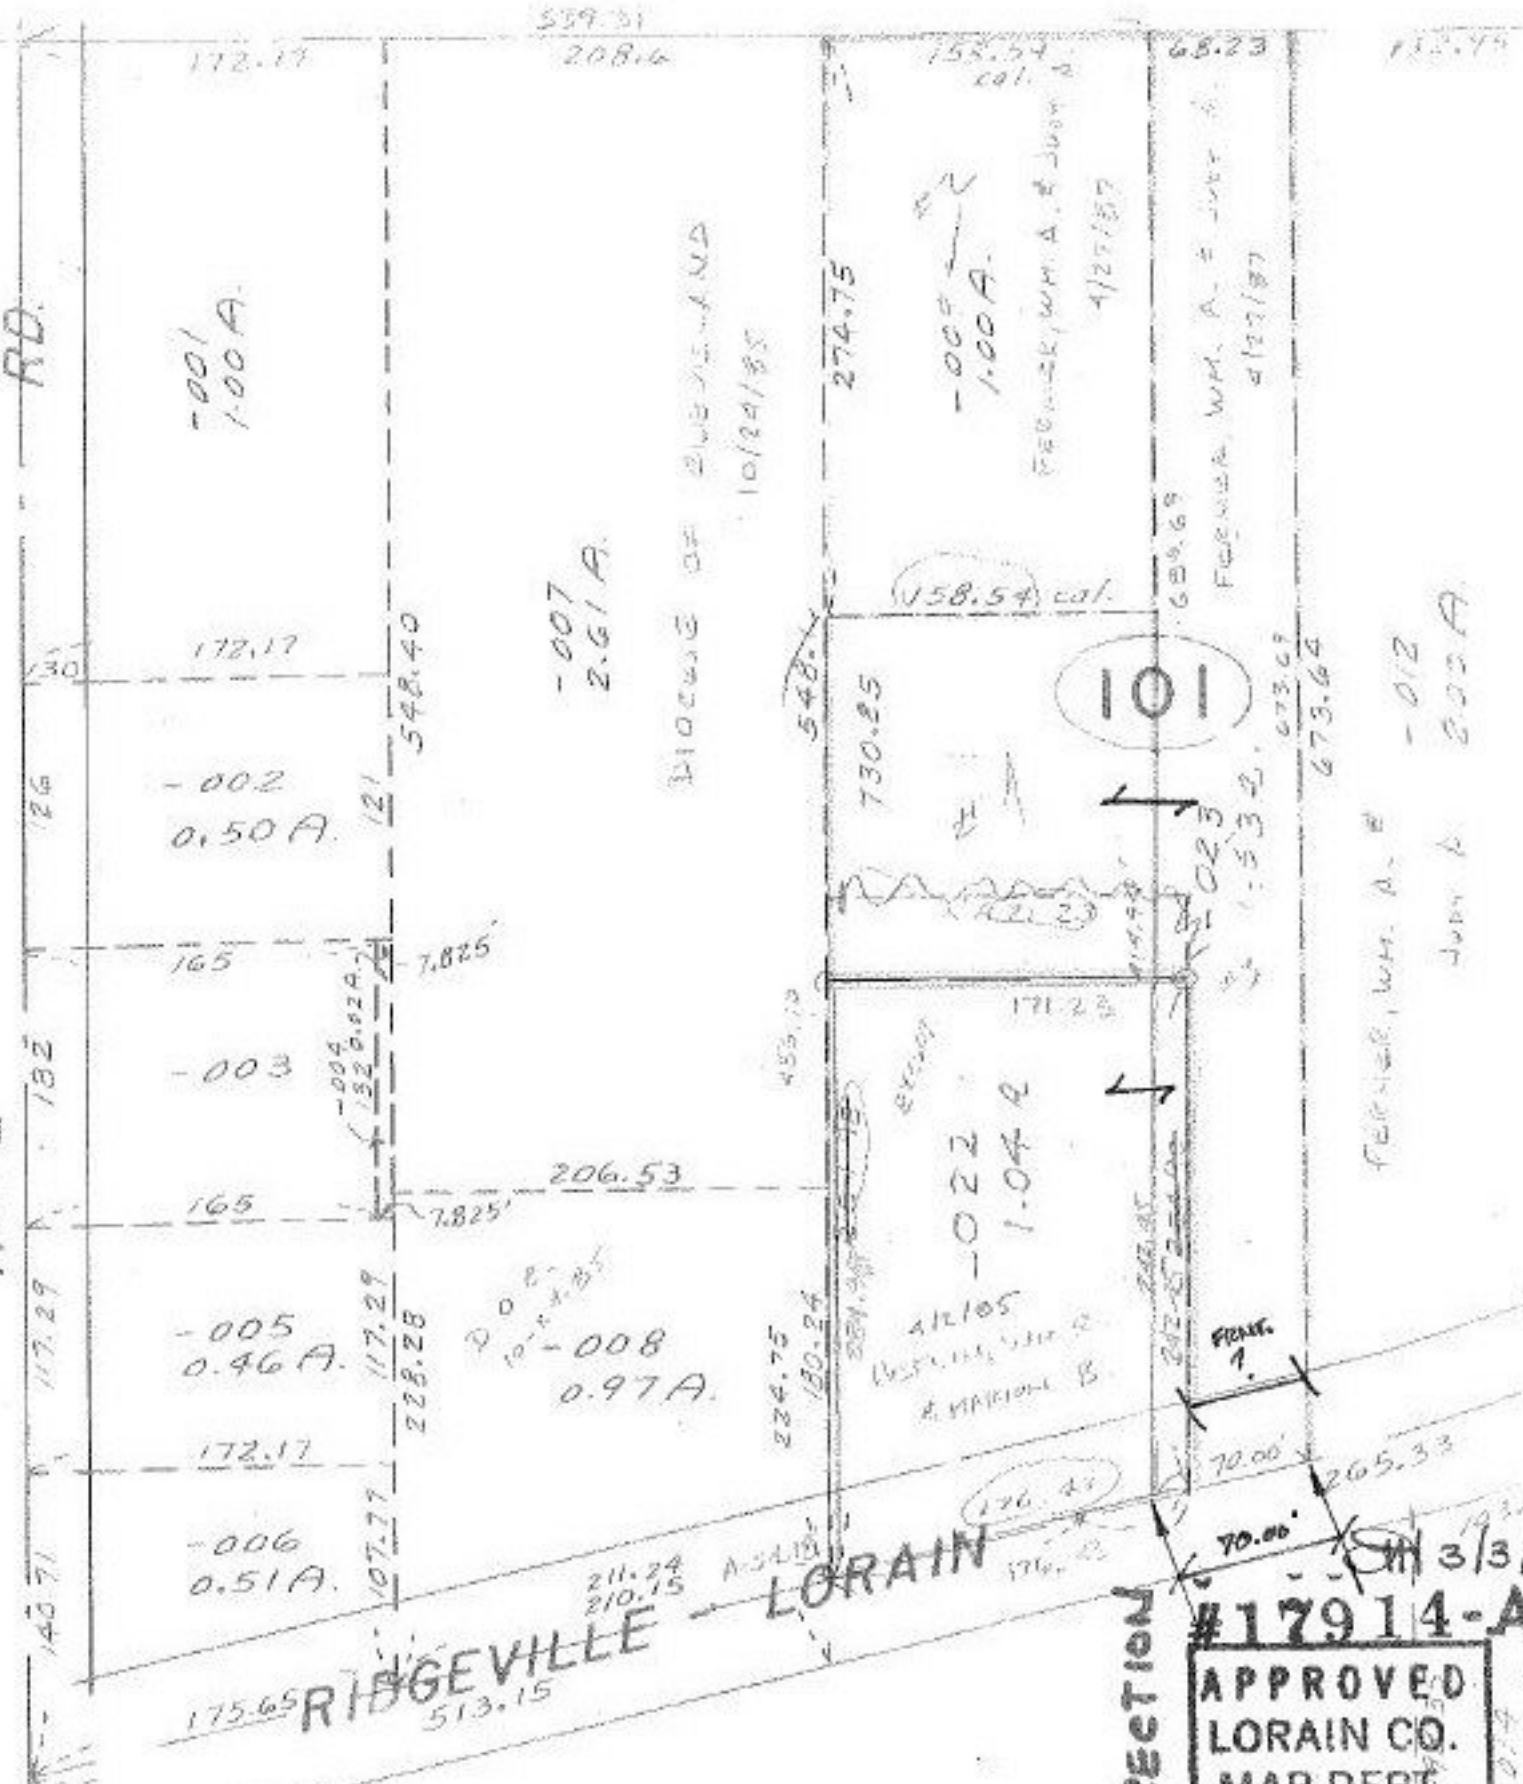

MAP CORRECTION

APPROVED
LORAIN CO.
MAP DEPT.

DATE 4-28-88

PAGE 3-00-007-A

BY T. McNeil

VOID AFTER 17914-A

3/3/89
#17914-A

-001
6.67 A.