


-016  
13.36 A.

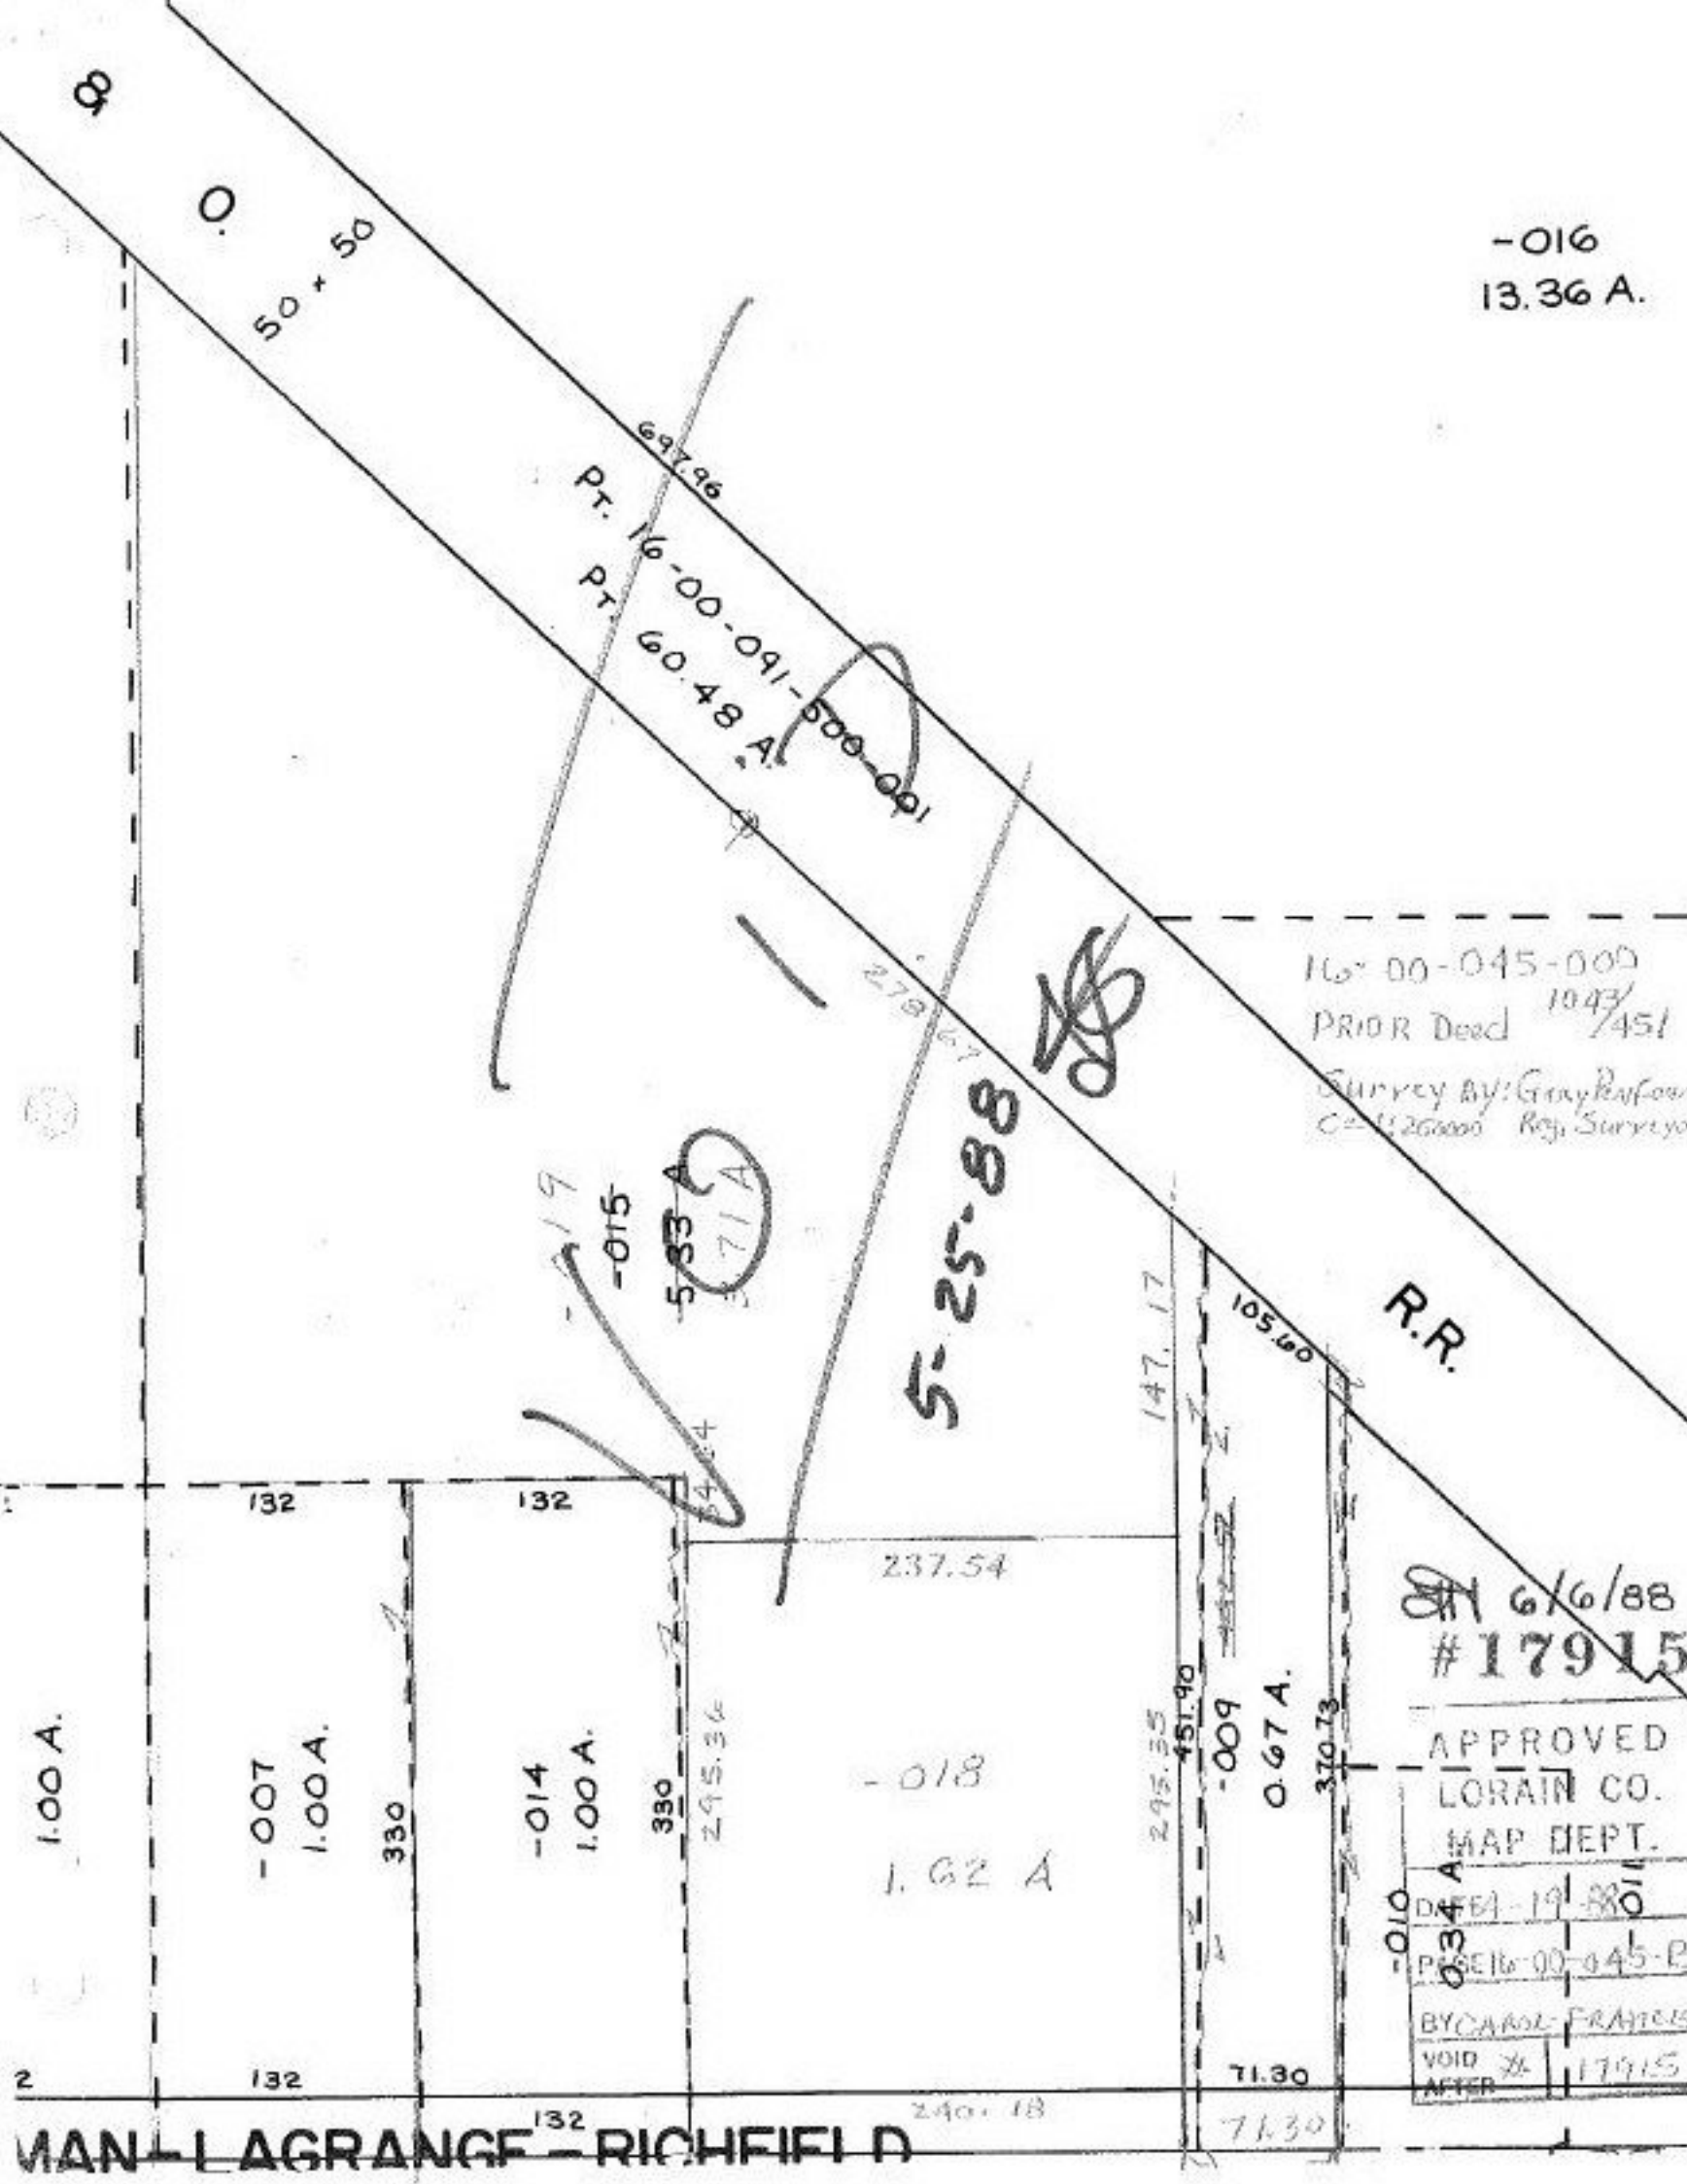

Pt. 16-00-091-500-001  
Pt. 60.48 A.

16-00-045-000  
PRIOR Deed 10/27/45  
Survey By: Gray Pearson  
C-426000 Reg. Surveyor

5-25-88

-019  
-015  
553  
71A

R.R.

6/6/88  
#17915

APPROVED  
LORAIN CO.  
MAP DEPT.

034 A  
DECEMBER 19 1980  
P. 00-045-B  
BY CAROL FRANCIS  
VOID AFTER 17915

1.00 A.

-007  
1.00 A.

-014  
1.00 A.

-018

1.62 A

0.67 A.

MAN - LAGRANGE - RICHFIELD