


SEE 12-00-020-A

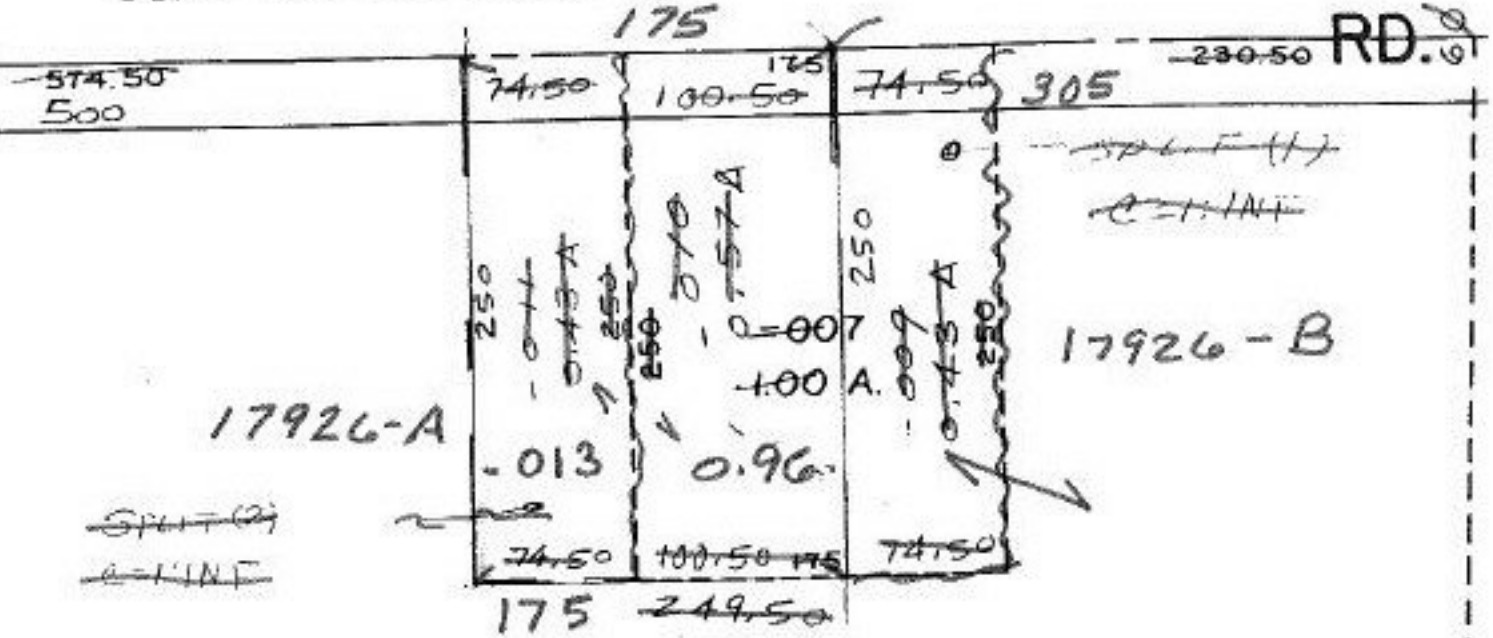

5/3/88  
**COMBINATION**

~~014~~  
 Pt. ~~93.37~~ A.  
 94.30 A.

#17926-B  
 #17926-A

Pt. ~~008~~  
 Pt. 94.30 A

APPROVED LORAIN CO. MAP DEPT.
DATE 4-28-88
PAGE 12-00-019-A
BY CAROL FRANCIS
VOID AFTER * 17926-A

12-00-019-000

~~RORO ETC.~~

~~(1) 1398-503 C-LINE~~

~~(2) 1412-751, 760 C-LINE~~

Survey by John G. Sawyer  
 Reg. Surveyor

#17855  
 APPROVED  
 LORAIN CO.  
 MAP DEPT.  
 DATE 2-25-88  
 12-00-019-A  
 Carol Francis  
 AFTER \* 17855

853.00