


SEE 12-00-020-A

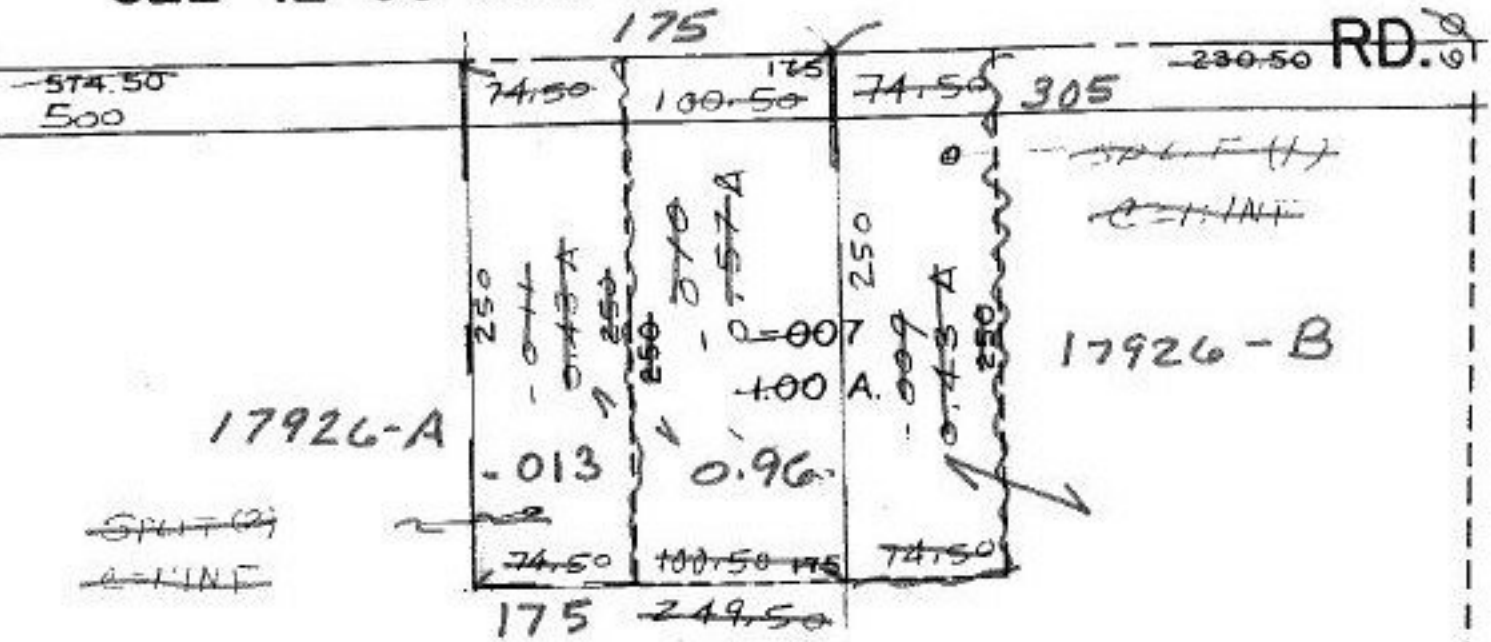

5/3/88
COMBINATION

~~pt. - 012~~
 pt. ~~93.37 Ac.~~
 94.30 A.

#17926-B
 #17926-A

pt. ~~008~~
 pt. 94.30 A.

APPROVED LORAIN CO. MAP DEPT.
DATE 4-28-88
PAGE 12-00-019-A
BY CAROL FRANCIS
VOID AFTER * 17926-A

12-00-019-000
 RATIO ITS.
 (1) 1398-503 C-LINE
 (2) 1412-751, 760 C-LINE
 Survey by John G. Sawyer
 Reg. Surveyor

#17855
 APPROVED
 LORAIN CO.
 MAP DEPT.
 DATE 2-25-88
 BY 12-00-019-A
 CAROL FRANCIS
 VOID AFTER * 17855

853.00