

290.40

378.40

- 052

5.59 A

-017

5.00-A.

- 051

pt. -048

pt. 78.93 A

~~76.84 A~~

76.83 A

calc.

# COMBINATION

*As per*  
Average A Section  
From ~~Iron~~ *Iron* ~~Sheet~~ *Sheet*.


SA 5/4/88

#17926-C

APPROVED
LORAIN CO.
MAP DEPT.
DATE 4-28-88
PAGE 13-00-043-C
BY CAROL-FRANCIS
VOID AFTER 17926-C

#17851

APPROVED
LORAIN CO.
MAP DEPT.
DATE 2-23-88
VOID AFTER 17851
BY Carol Francis

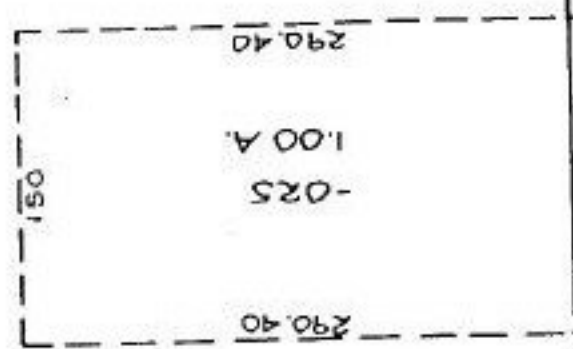

18-00-043-000

PRISM BOARD

Survey - by David L. Edward  
Reg. Surveyor - C. H. H. N. E.  
① C-17-102300

PECK - WADSWORTH

SA 5/4/88  
#17926-C

150

1247.74 FROM E  
TO PLACE OF BEING

SEE 18-00-00