


13 14, 26 10 &  
+ Oster & Harris  
Ad

OSTER

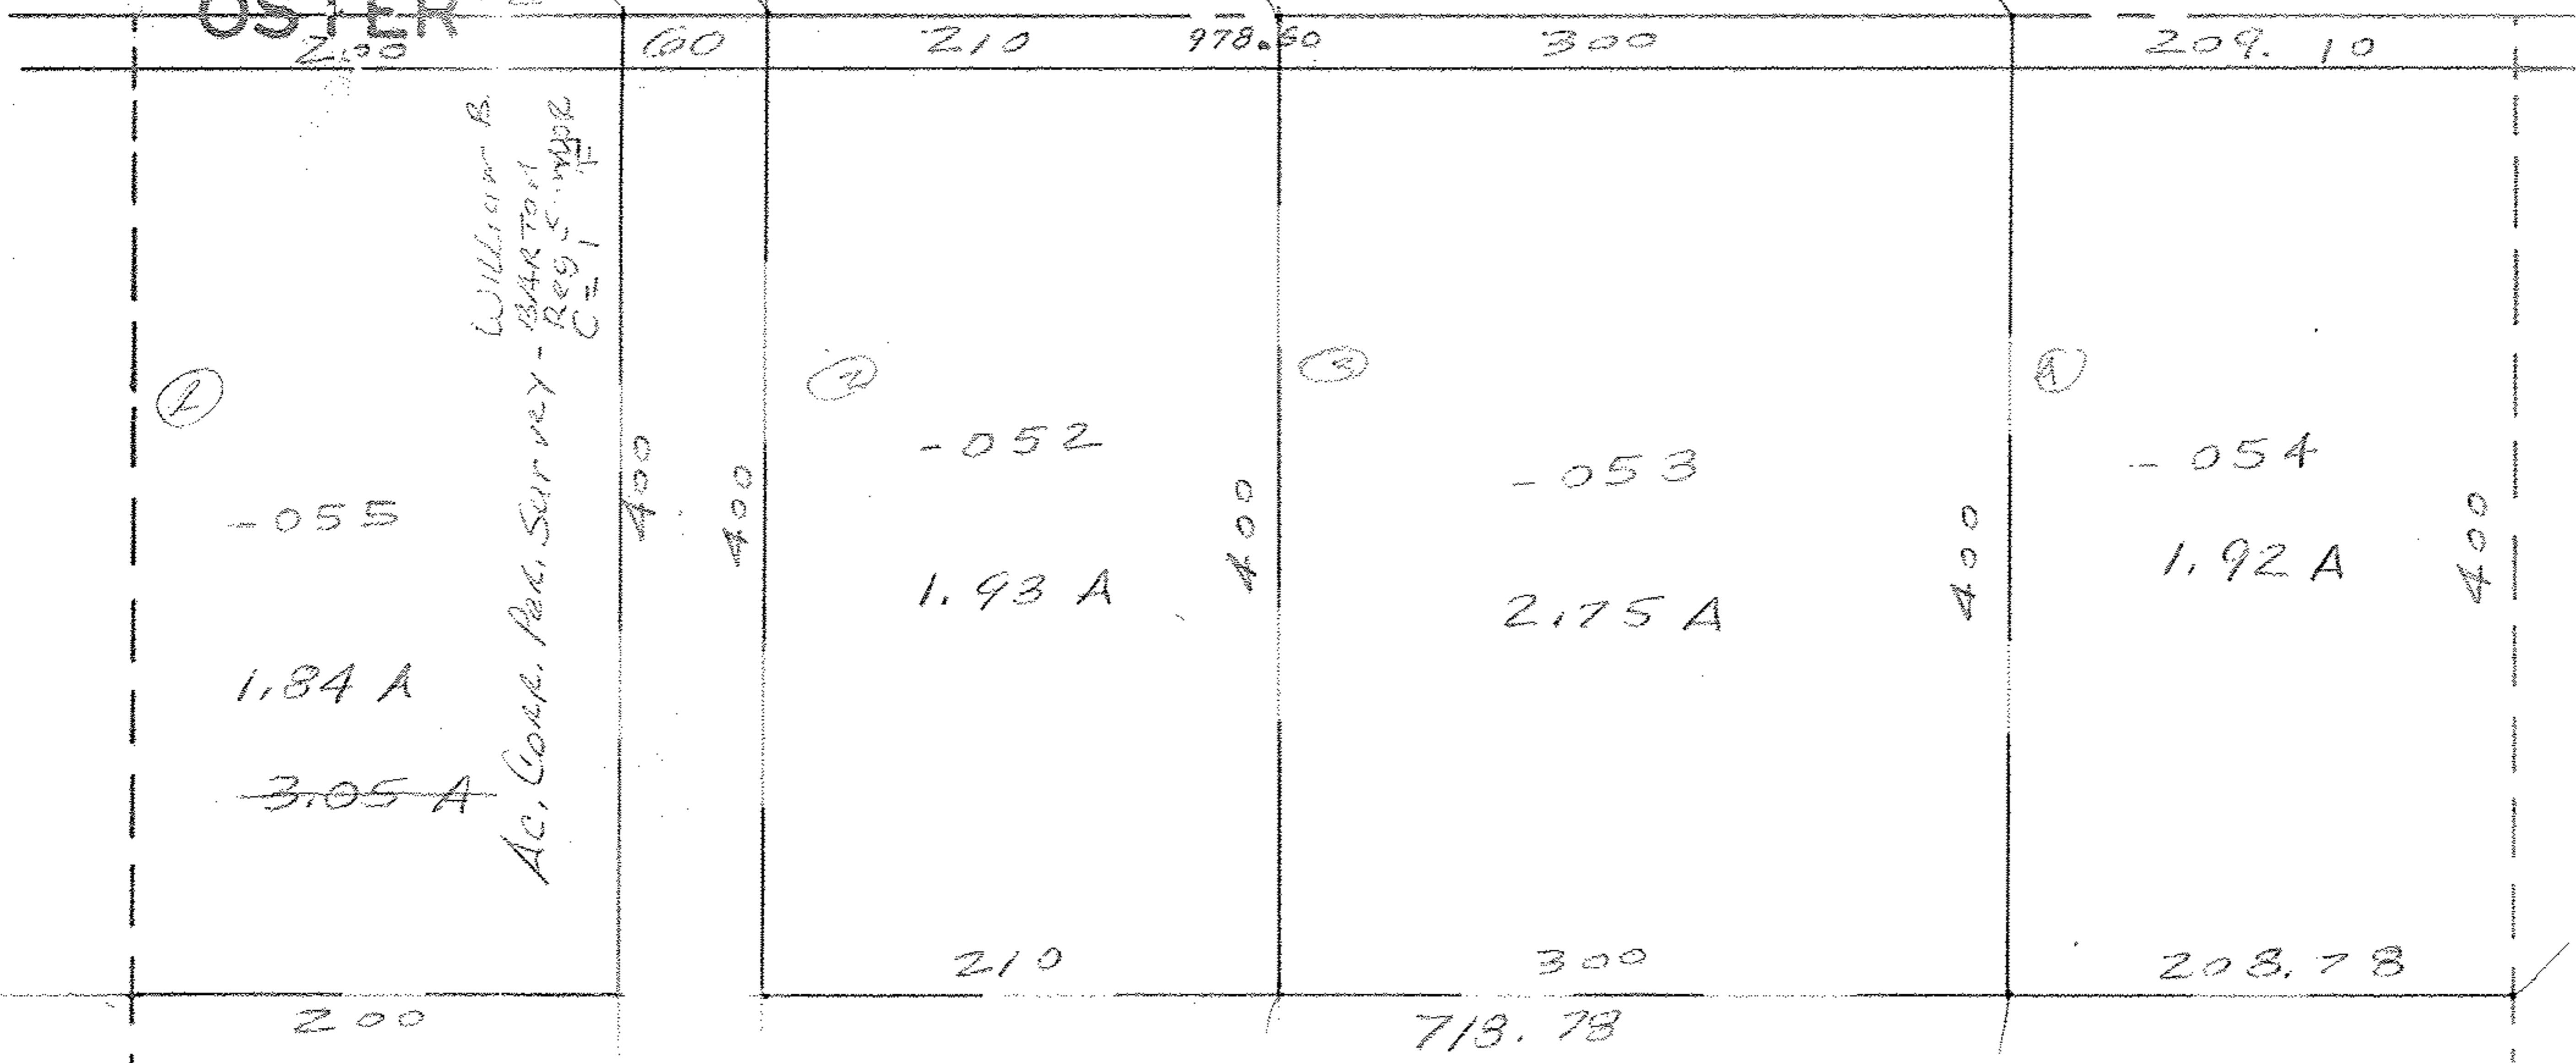

1. C=1:500000  
2 & 3 C=1:111NF  
4. C=1:2000000

~~033~~ 17938  
~~23.93 A.~~

①

- 051  
14.28 A.

6/6/88  
# 17938

APPROVED LORAIN CO. MAP DEPT.	
DATE	5-11-88
PAGE	3-00-024-B
BY	CAROL FRANCIS
VOID AFTER	17938

03-00-024-000  
Prior Deed O.R. 47 / 171  
Survey - W. B. Barton  
C=1:50000

978.40  
~~978.50~~  
978.50

1005.56

616.01

1005.64

605.91

4589.30