


Pt. -036
Pt. 52.71 A.

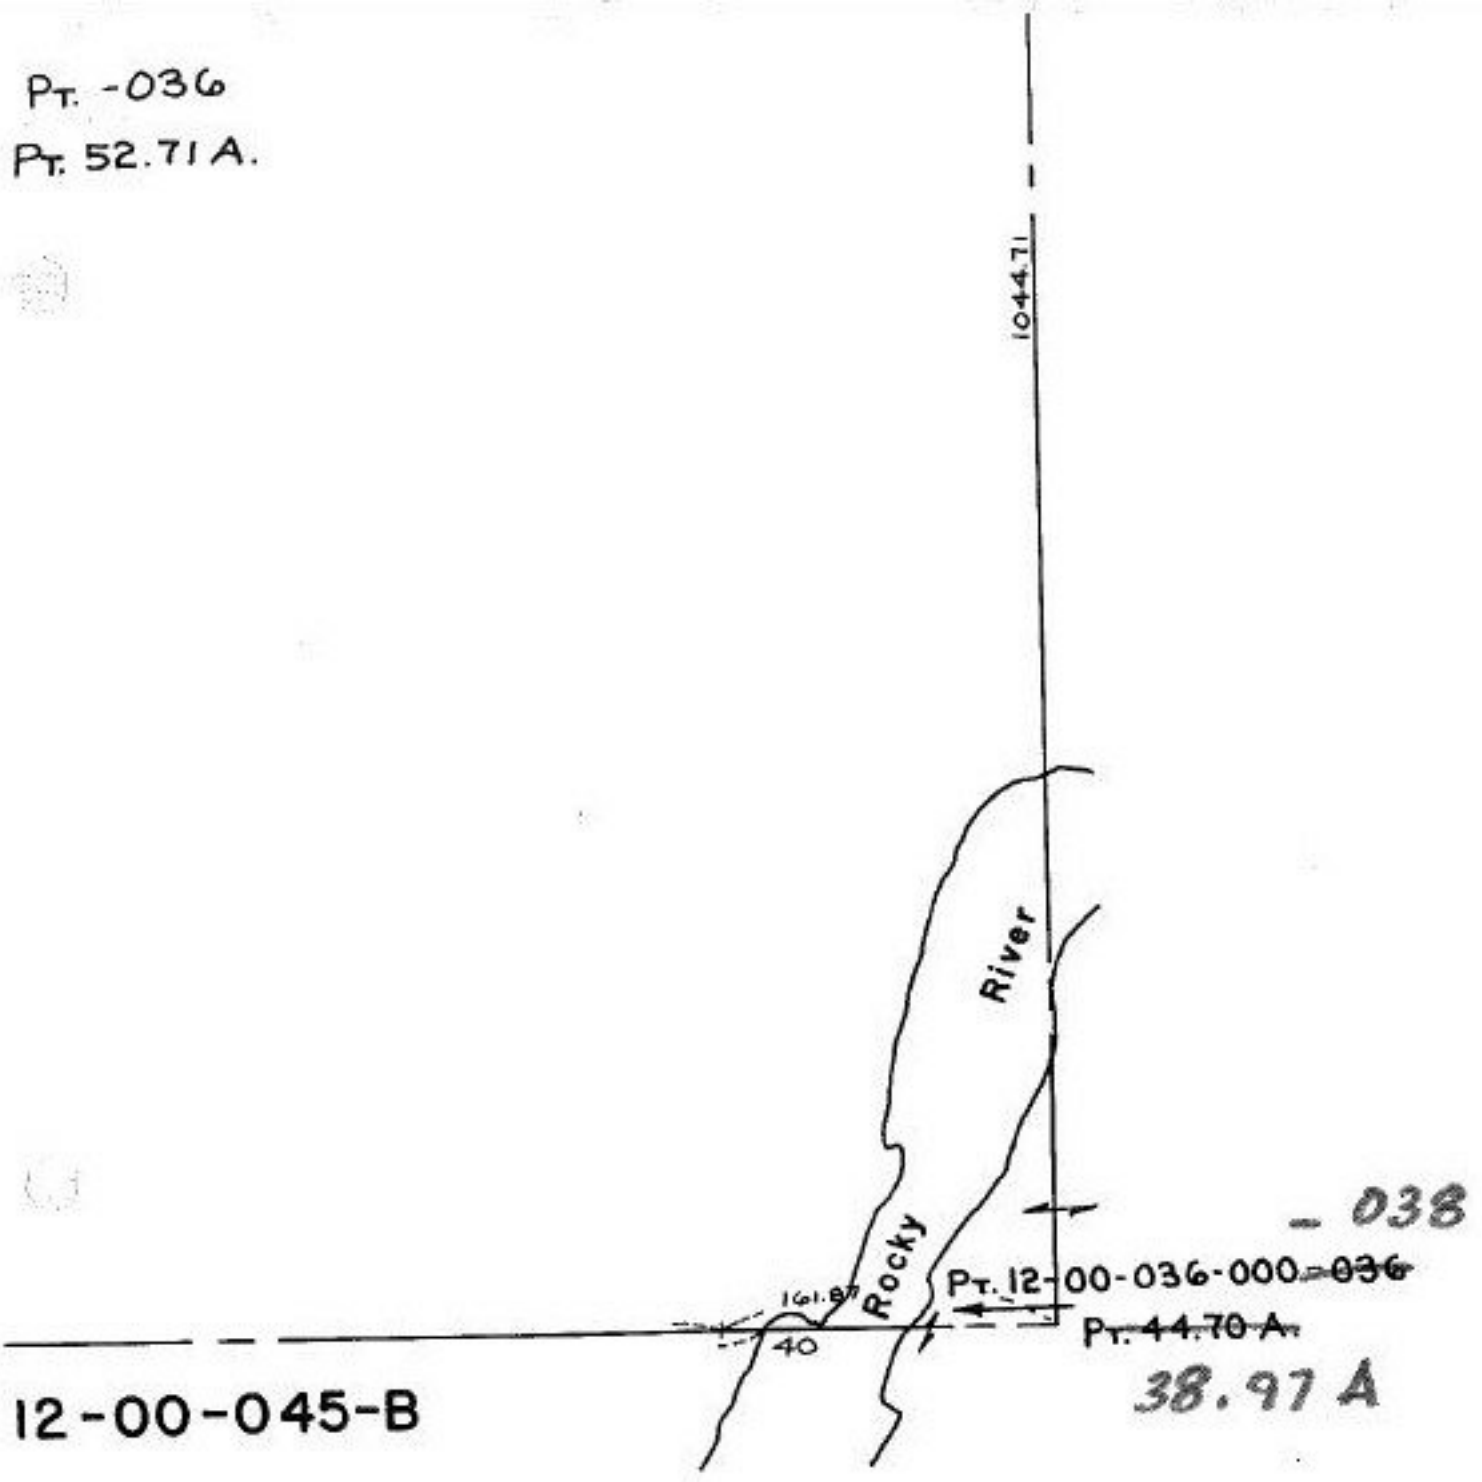

12-00-045-B

12-00-036-000

ELY. PT. LOT 44

SW 10/6/88
17948

APPROVED LORAIN CO. MAP DEPT.
DATE 5-18-88
PAGE 12-00-044-13
BY CAROL FERRIS
VOID AFTER <input checked="" type="checkbox"/> 17948