


**VOID
NEVER TRAN.
OR
RECORDED
5-27-88**

[Handwritten signature]

**TAKEN
MAP. DEPT. #13730
BY
Rich Buzas #13729**

846.70

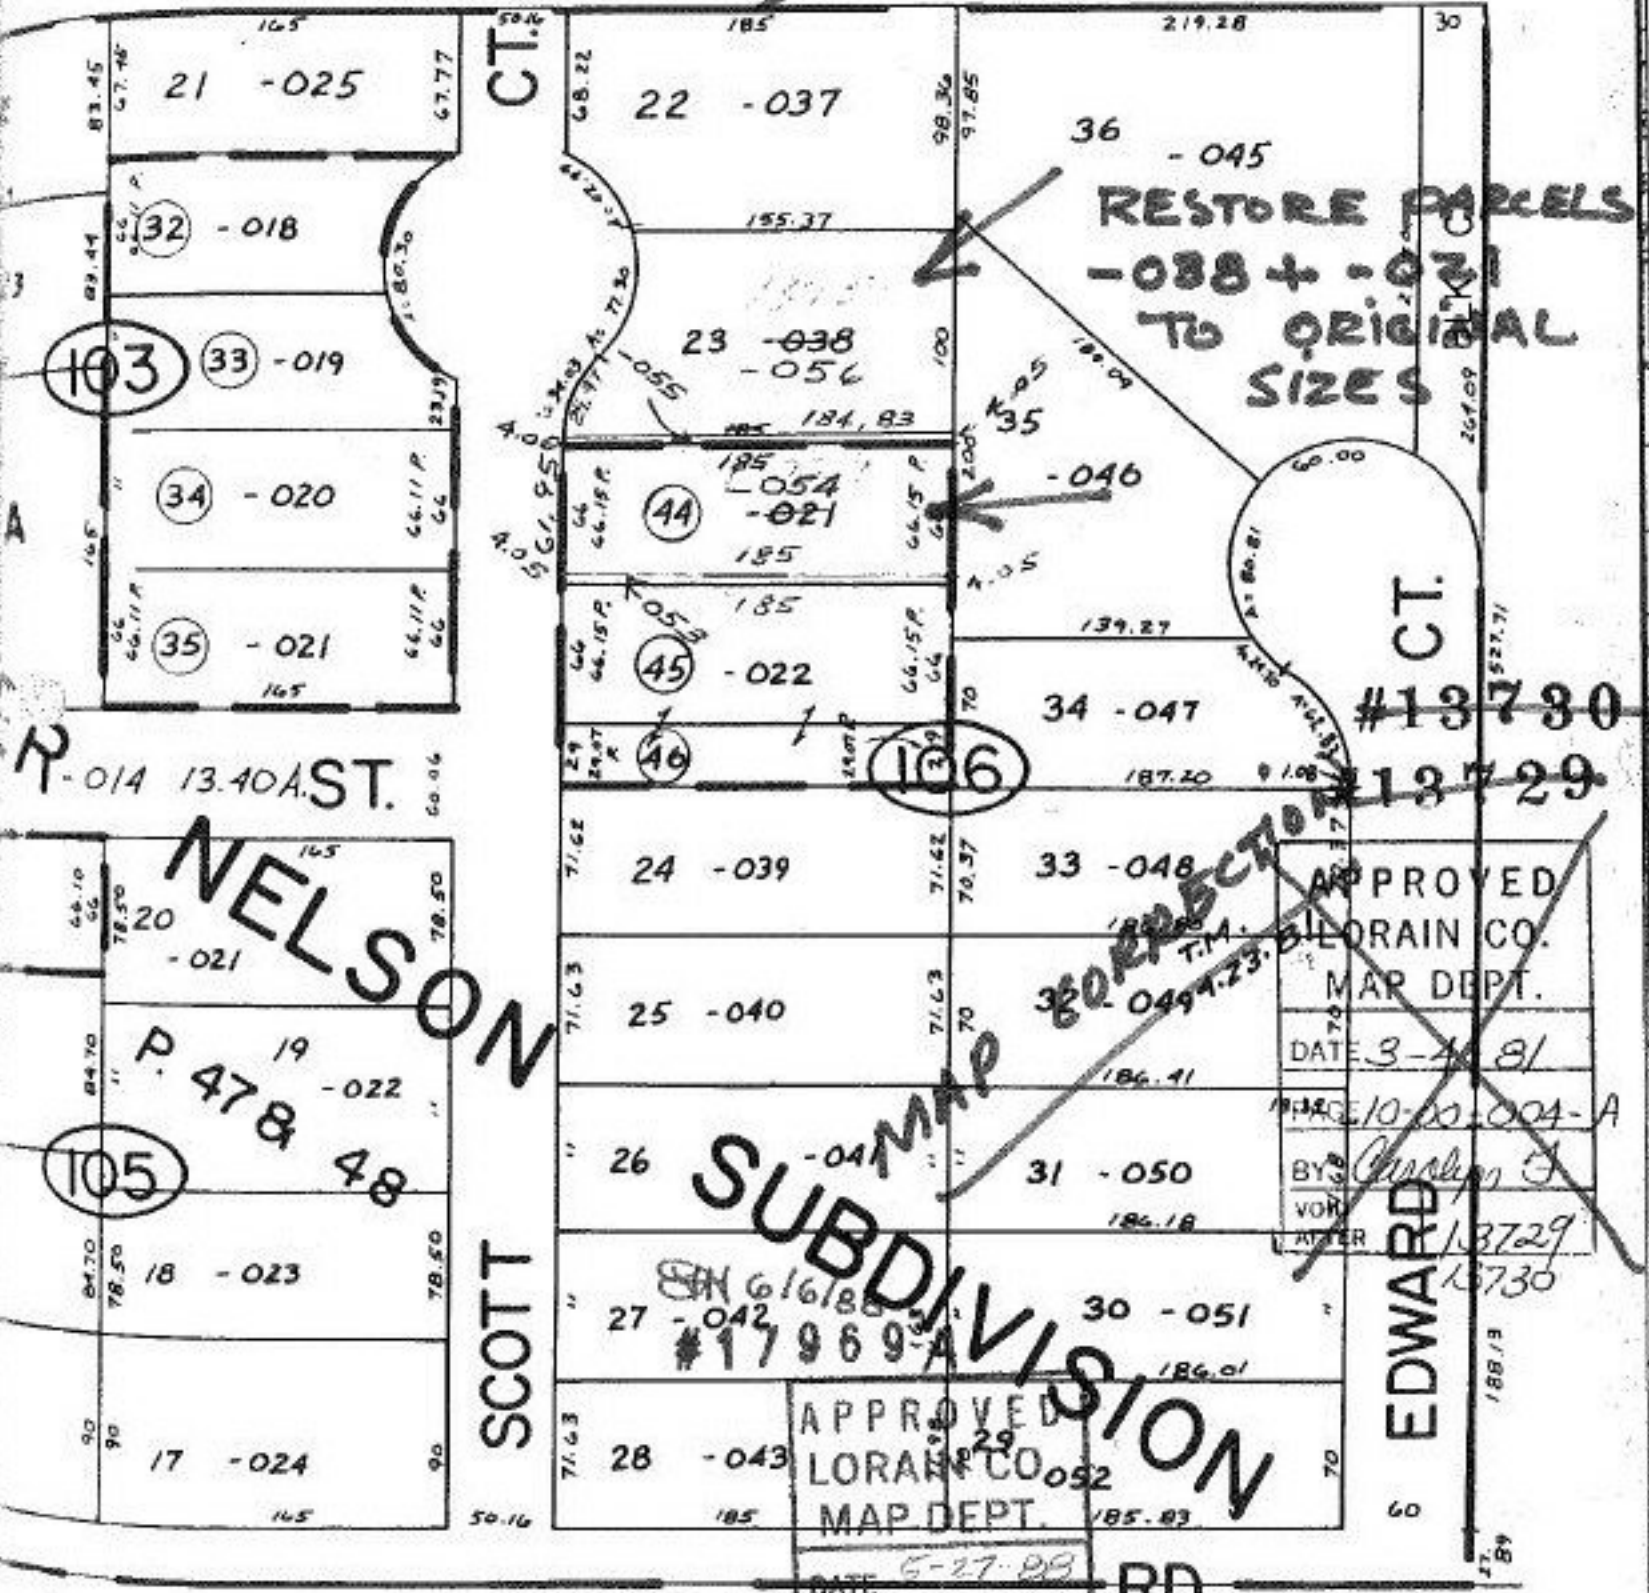

N-014 13.40A ST.

NELSON

P. 478 48

SCOTT CT.

CT.

EDWARD

APPROVED
LORAIN CO.
MAP DEPT.

APPROVED
LORAIN CO.
MAP DEPT.
DATE 3-4-81
BY *[Signature]*
VOID AFTER 13729

DATE 5-27-88

RD.

10-00-004-E

#17969-A

PAGE 10-00-004-A

BY *[Signature]*

VOID AFTER 17969A