
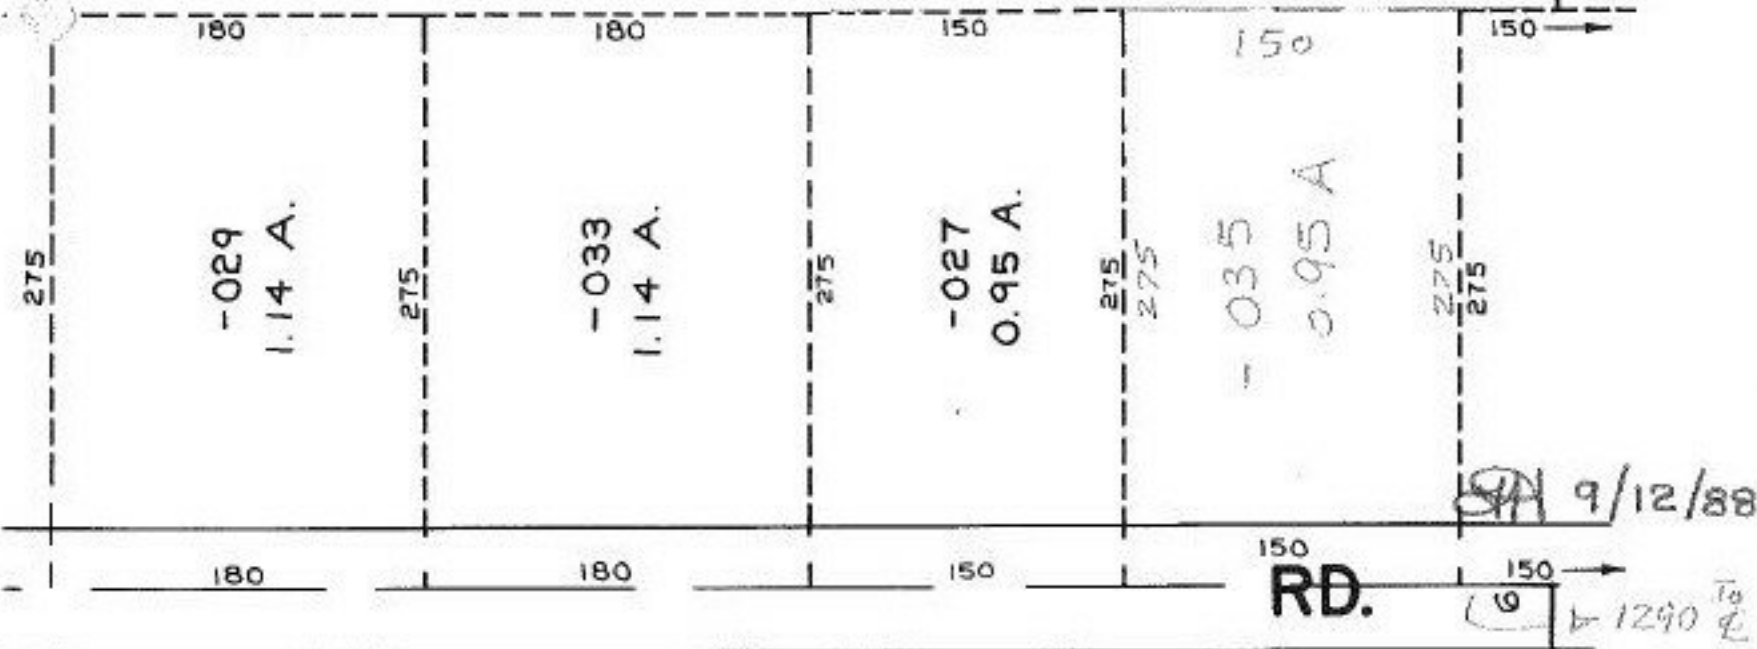


Pt. -034
Pt. 47.56 A.

- 036
44.62 A

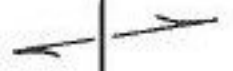

SA 9/12/88
G 1290 To

#17971

10-00-015-114
Prior Deeds 749 - 525
1100 - 25
Map by Arnold Koepf - Reg. Surveyor.

APPROVED
LORAIN CO.
MAP DEPT.

DATE 2-88

PAGE 10-00-015-114

BY CAROL FRANCIS

VOID AFTER #17971

Pt. -020
Pt. 16.86 A.

10-00-015-G