


Pt. 12.17 A.

60 88° 50' 73

116
61A.

26-B

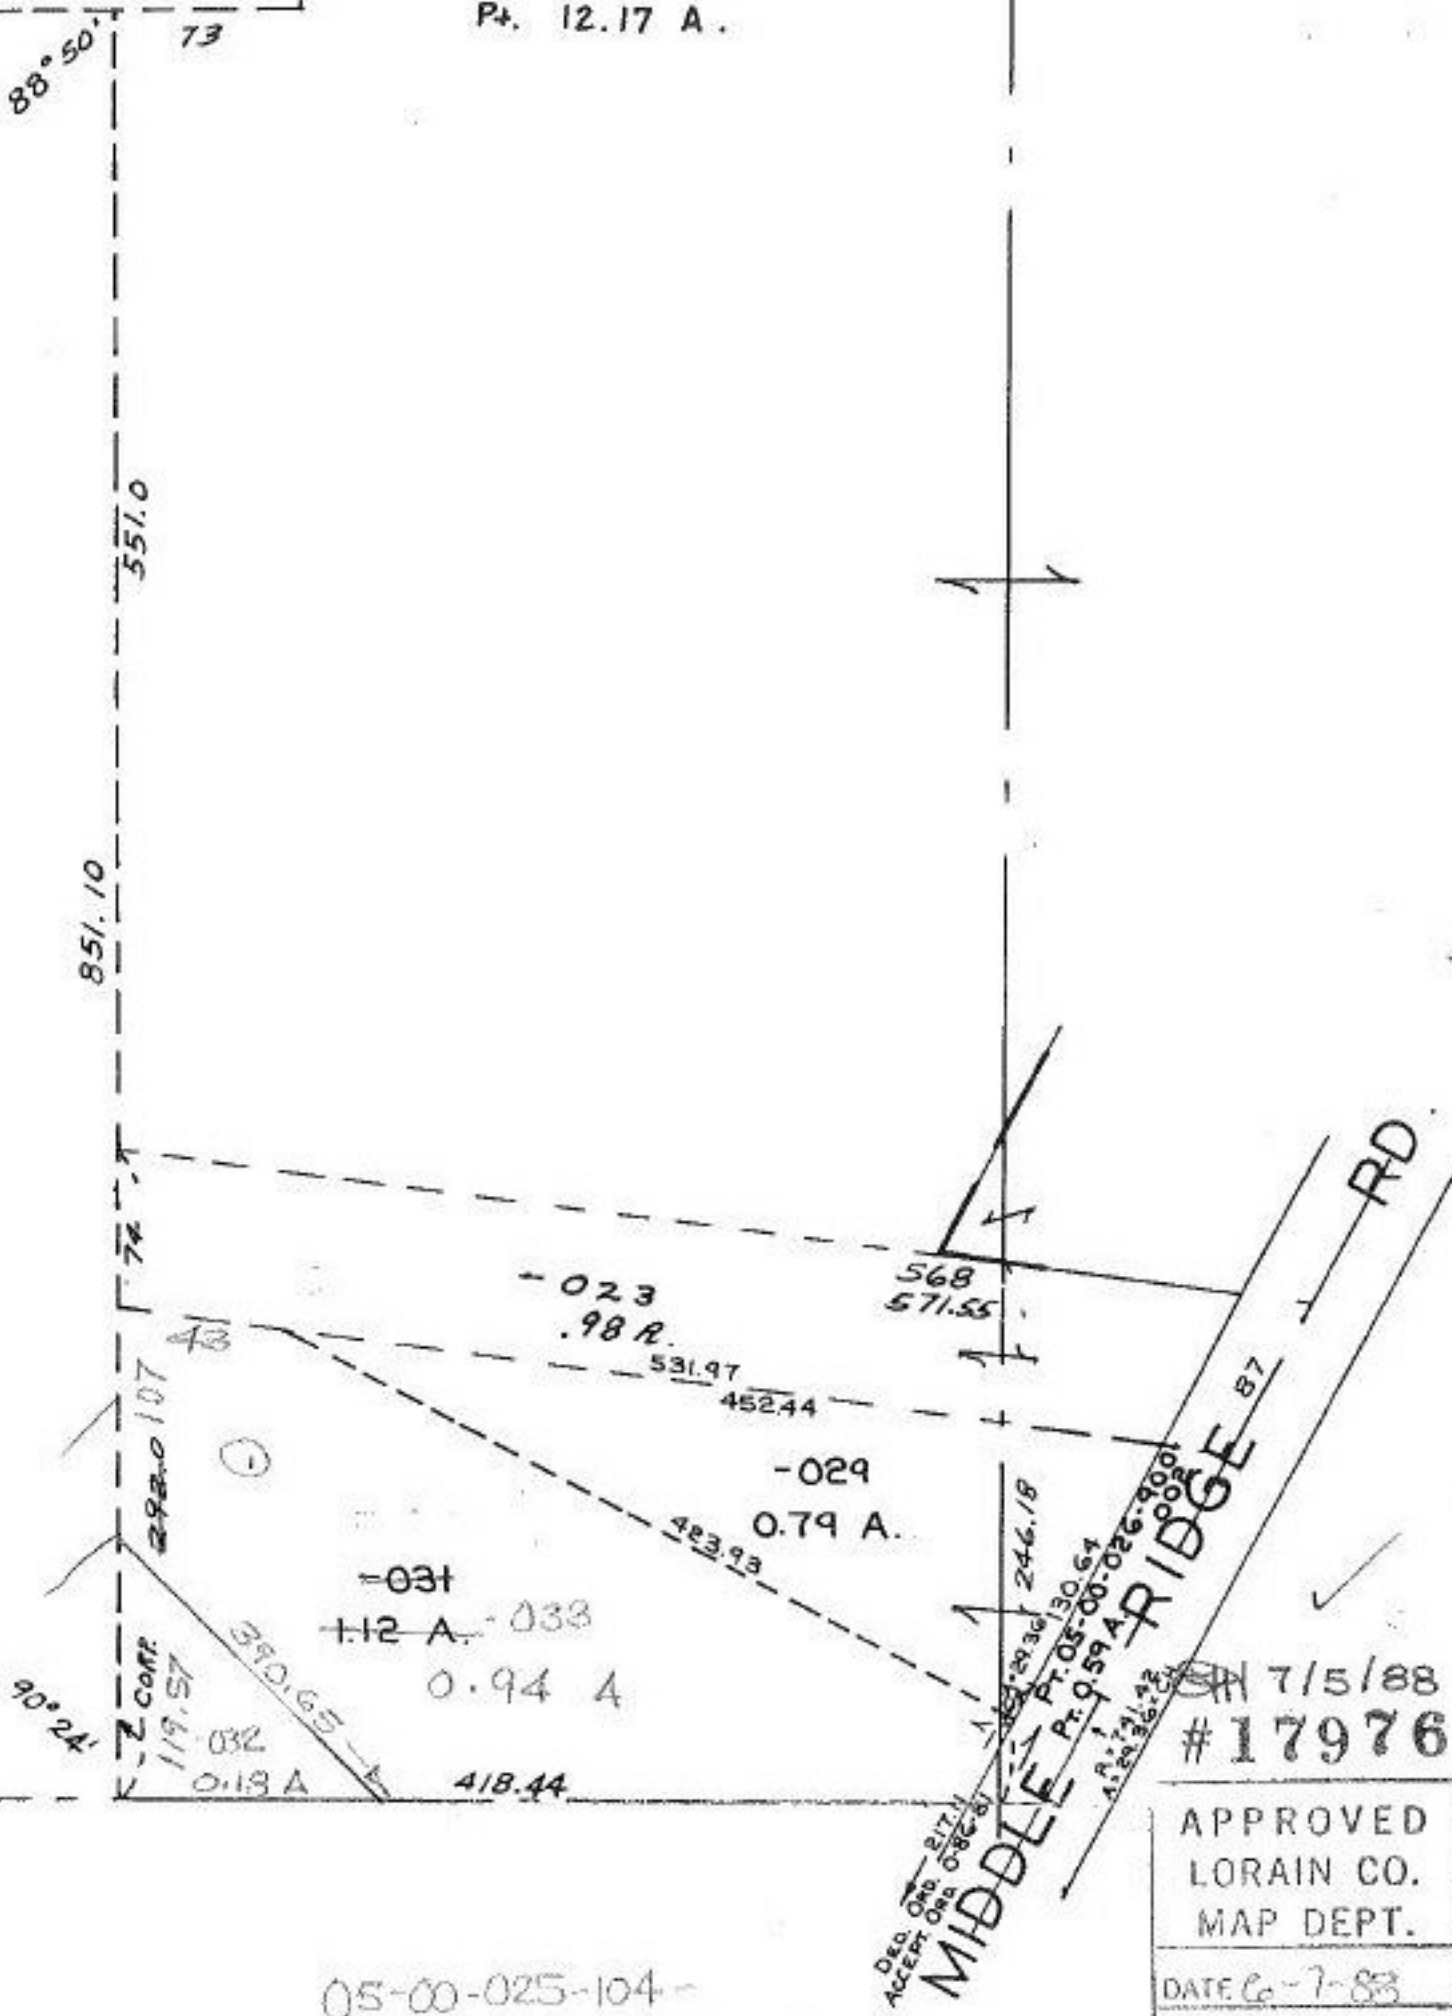

Dea. One 217.71
 ACCEPT Dea. 086.81
 MIDDLE RIDGE RD
 Pt. 05-00-25-104
 Pt. 9-59-00-026-9001
 A.A. 24.21, 22.24
 246.18
 189.29, 36.54

715/88
 # 17976

APPROVED
 LORAIN CO.
 MAP DEPT.
 DATE 6-7-83
 PAGE 5-00-025-B
 BY C. AND L. FRONERS
 VOID AFTER # 17976

05-00-025-104-
 PRIOR Deed 113-712
 Survey by: MICHAEL G. HURA
 ① C=4,100,000 Reg. Surveyor
 ② C=12,500