


-024
←-001
20.37 A.
20.03 A.

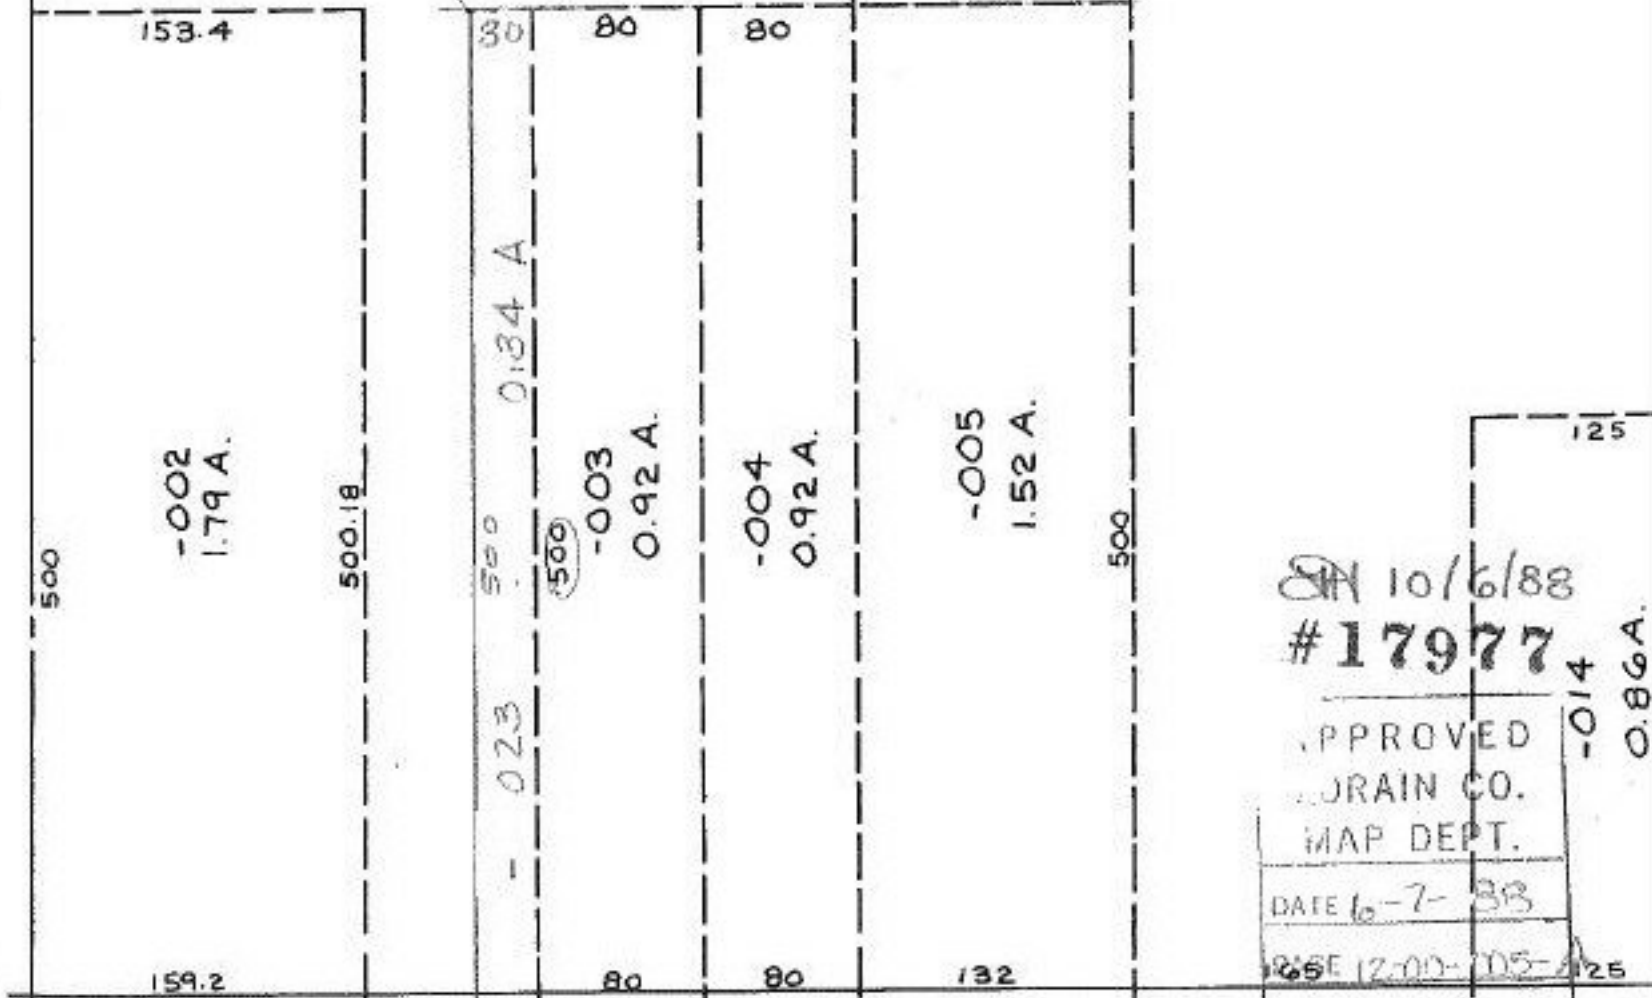

ELYRIA - TWINSBURG

12/00-005-101 - Plan D, 964-643
Survey by John Hamilton 938-961

10/6/88
#17977

APPROVED
LORAIN CO.
MAP DEPT.

DATE 10-7-88

125
CASE 12-00-005-125

BY *John Francis*

VOID AFTER 82 17977

SEE